


T.30S.R.15 W.W.M.

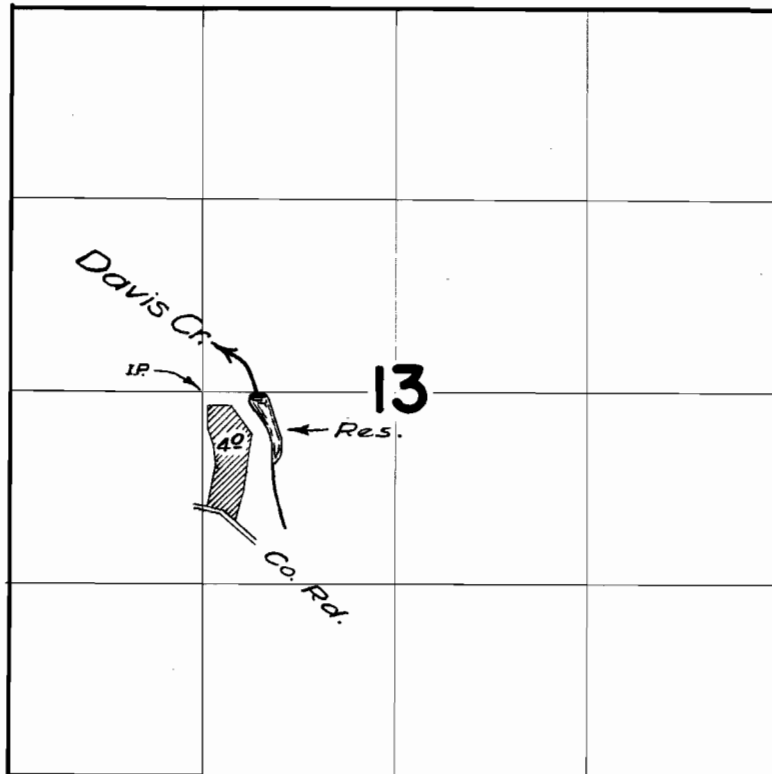

**FINAL PROOF SURVEY**  
UNDER

Application No. *R-29421* 29115 Permit No. *R-1656* 23061  
IN NAME OF

*Floyd L. Shortridge*

Surveyed *22 April 1958*, by *m. Bish*