T.30 S.R.5W.W.M.

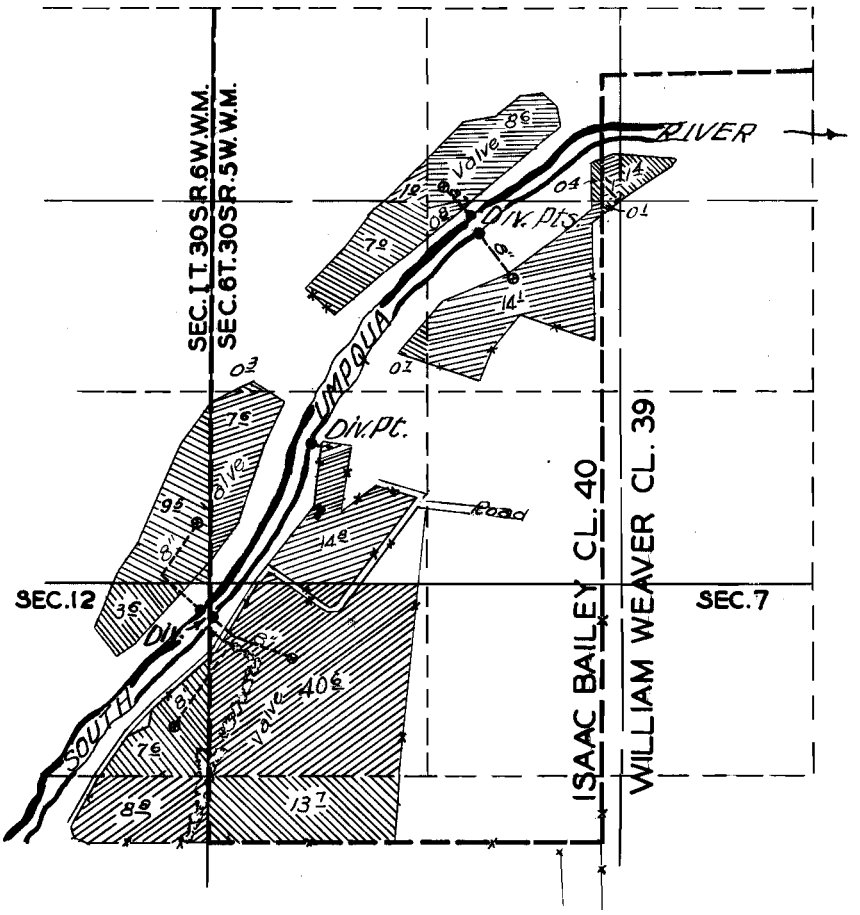

FINAL PROOF SURVEY

UNDER

Application No. 16401 Permit No. 12200

IN NAME OF

JAMES E. LEWIS

Surveyed JULY 27 1949, by H. L. COFFMAN.

1949 E