


T.24S., R.4W., W.M.

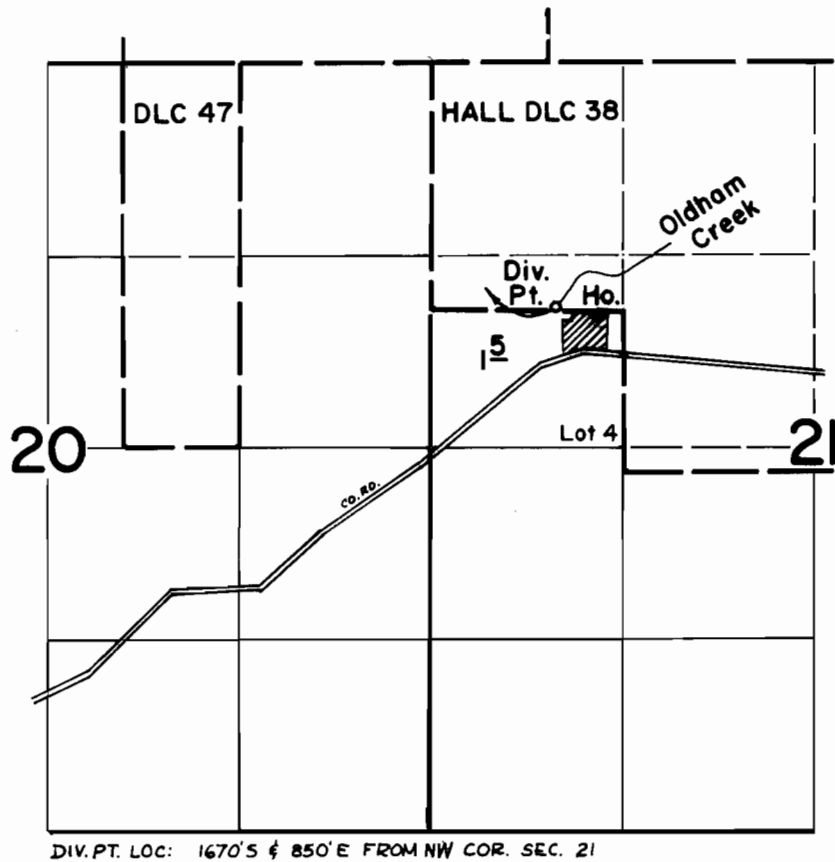

**FINAL PROOF SURVEY**  
UNDER

Application No. 43868 Permit No. 32780  
IN NAME OF

VESTA COTA

Surveyed July 26 1976, by D. Norby