


T.32S. R.6W. W.M.

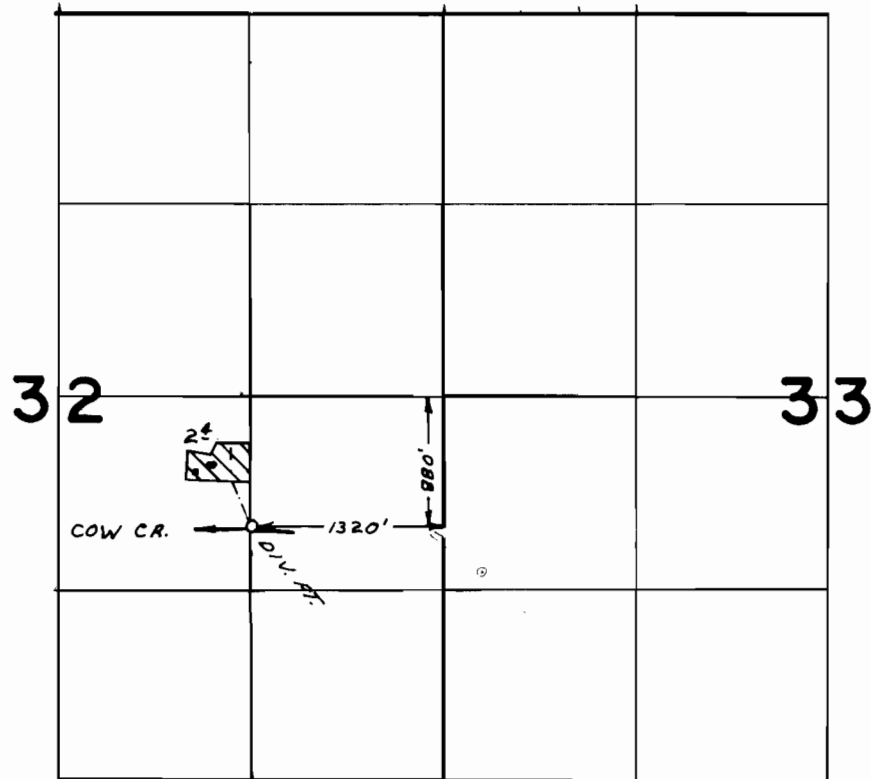

FINAL PROOF SURVEY
UNDER

Application No. 45994... Permit No. 34353...
IN NAME OF

FRANK A. PARKER

Surveyed JUL 13 1976, by L.H. NUNN