


T.32S. R.5W. W.M.

SEC. 35

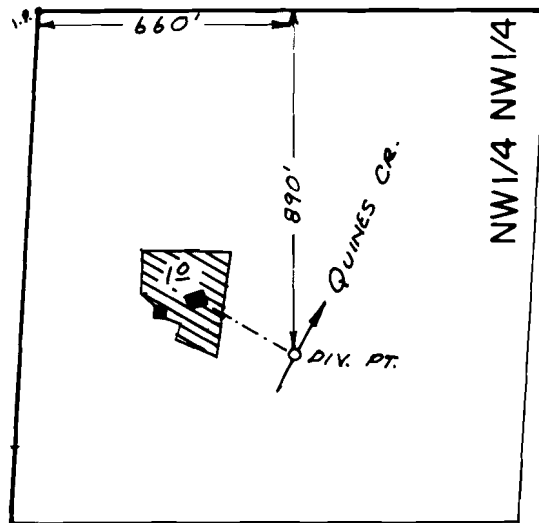

SCALE 1" = 500'

FINAL PROOF SURVEY
UNDER

Application No. 46385 Permit No. 34644
IN NAME OF

L.E. MULLARKEY

Surveyed JUL 13 1976, by L.H. NUNN