


T.38S., R.1W., W.M.

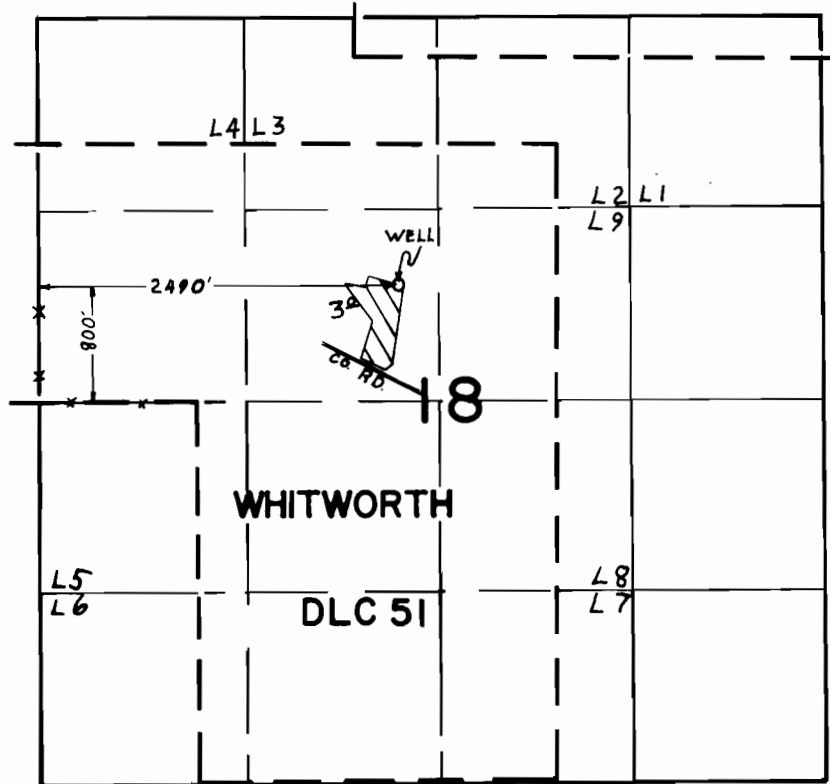

FINAL PROOF SURVEY
UNDER

Application No. G-5903 Permit No. G-5618
IN NAME OF

IRVING S. THOMAS

Surveyed APR. 28. 1976, by C.R. KING