


T.35S. RIW. W.M.

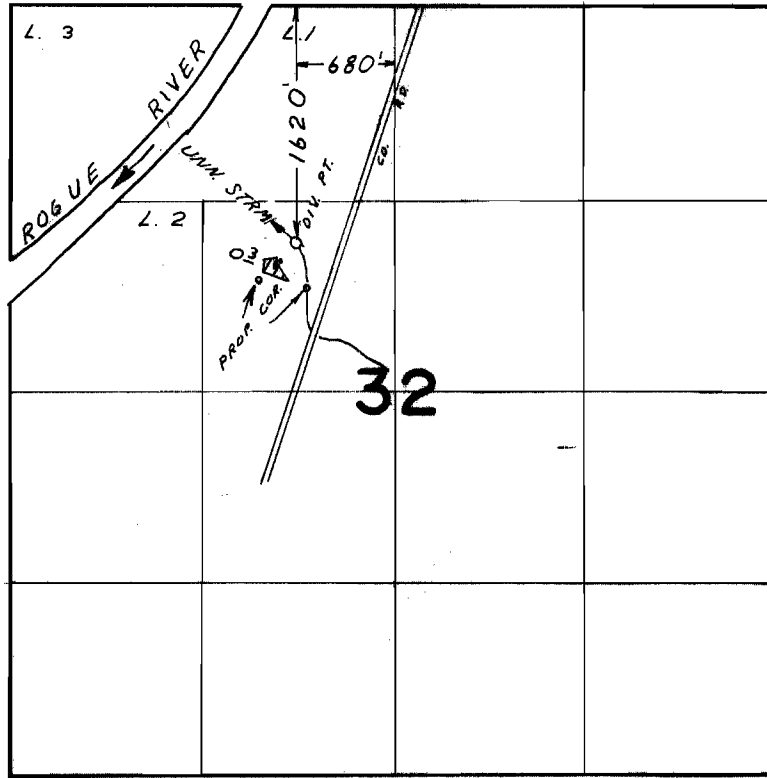

FINAL PROOF SURVEY UNDER

Application No. 43724 Permit No. 32682
IN NAME OF

DAVID M. & ANNE M.U. FRANKLIN

Surveyed APR. 23. 1975., by L.H. NUNN