


31785
45767

T.36S.R.11&12E.W.M.

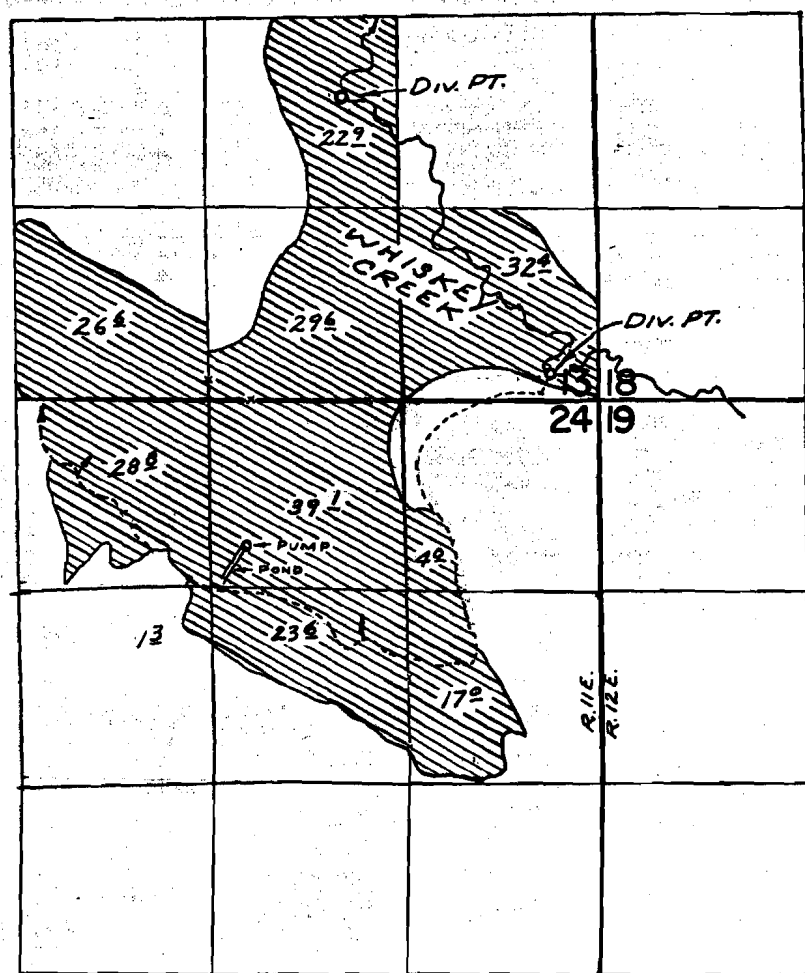

DIV. PT. LOC: 180' N. & 2340' E. FROM S 1/4 COR. SEC. 13
 2080' N. & 930' E. FROM S 1/4 COR. SEC. 13

FINAL PROOF SURVEY UNDER

Application No. 42541... Permit No. 31785....
 IN NAME OF

BRUCE S. & VIRGINIA A. TOPHAM

Surveyed OCT. 28, 1974, by R. MUCKEN
APR. 12, 1978 D. E. KNAUER