


T.17S. R.2W. W.M.

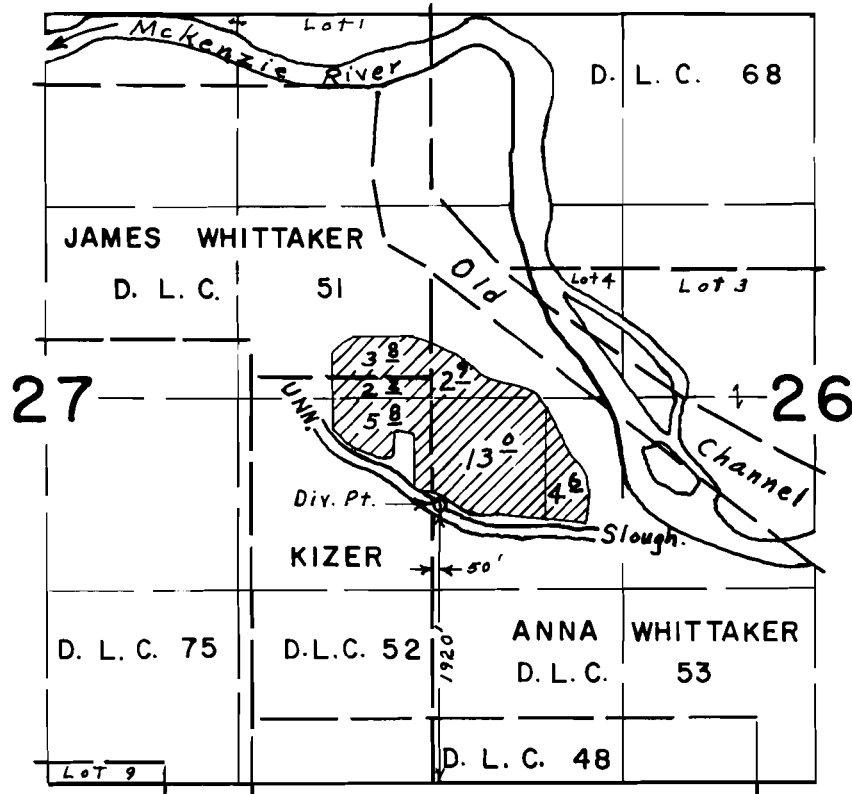

FINAL PROOF SURVEY UNDER

Application No. 45647 Permit No. 33411
IN NAME OF

E. D. FOX

Surveyed June 22, 1976, by L. E. Gould