


T. 6 S. R. 10 W. W.M.

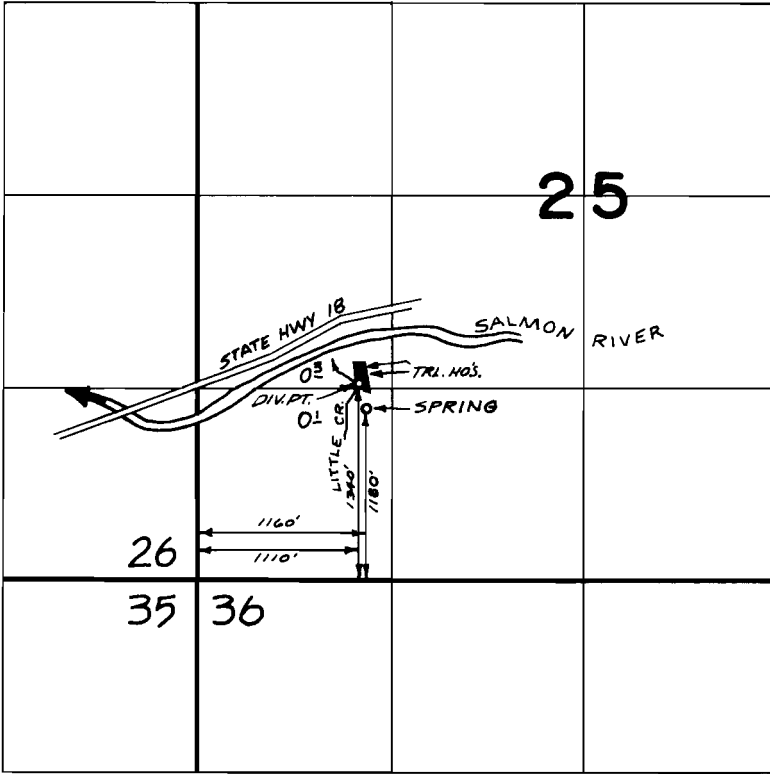

FINAL PROOF SURVEY
UNDER

Application No. 46117 Permit No. 34454
IN NAME OF

LE ROY O. AND/OR ELAINE I. NATE

Surveyed JUNE 28 76 C.R. KING
JULY 18 1974 by D. NORBY