


T.18S. R.41E. W.M.

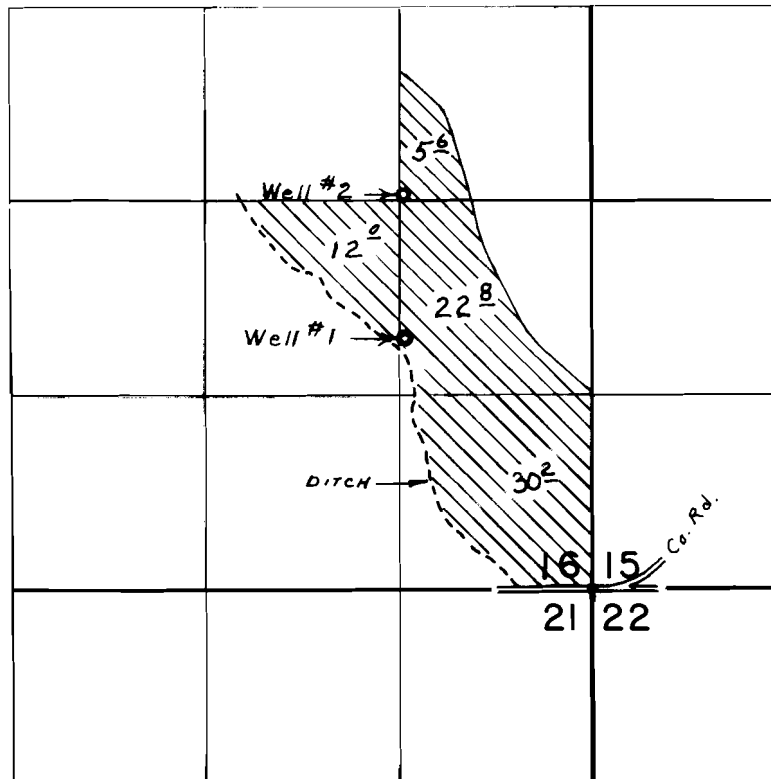

Wells located: #1, 1720' N. & 1280' W.; #2, 2710' N. &
1290' W., both from S. E. Cor. Sec. 16

FINAL PROOF SURVEY
UNDER

Application No. G-5402. Permit No. G-5327.
IN NAME OF

GRADY & MARTHA ROMANS

Surveyed May 4, 1976, by L. E. Gould