


# T.19S. R.44E. W.M.

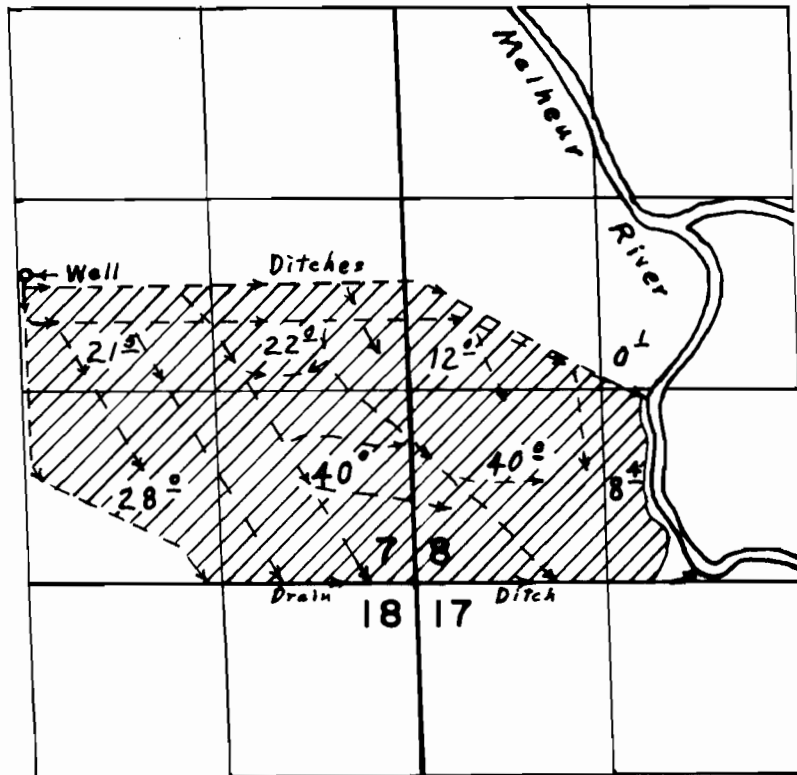

Well located 2120' N. & 2670' W. from S. E. Cor. Sec. 7

## FINAL PROOF SURVEY UNDER

Application No. G-5729 Permit No. G-5529  
IN NAME OF

BISHOP BROTHERS

Surveyed May 4, 1976, by L. E. Gould