


T.14S. R.39E. W.M.

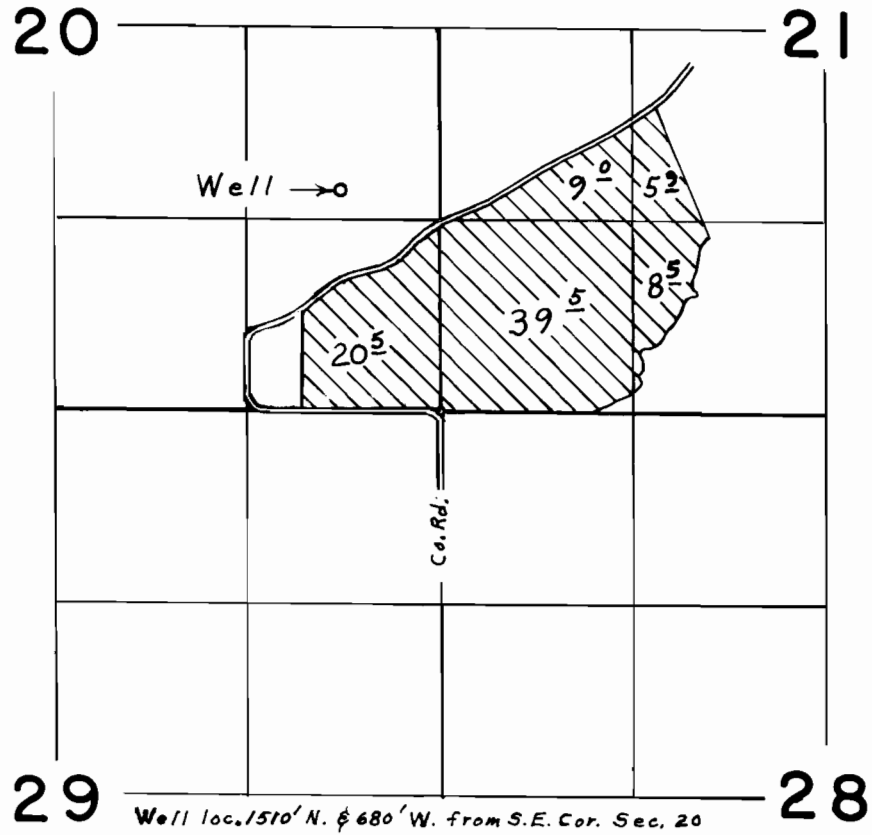

**FINAL PROOF SURVEY**  
UNDER

Application No. G-6391 Permit No. G-5982  
IN NAME OF

JOHN MOLTHAN

Surveyed April 28, 1976., by L. E. Gould.