


T.18S. R.47E. W.M.

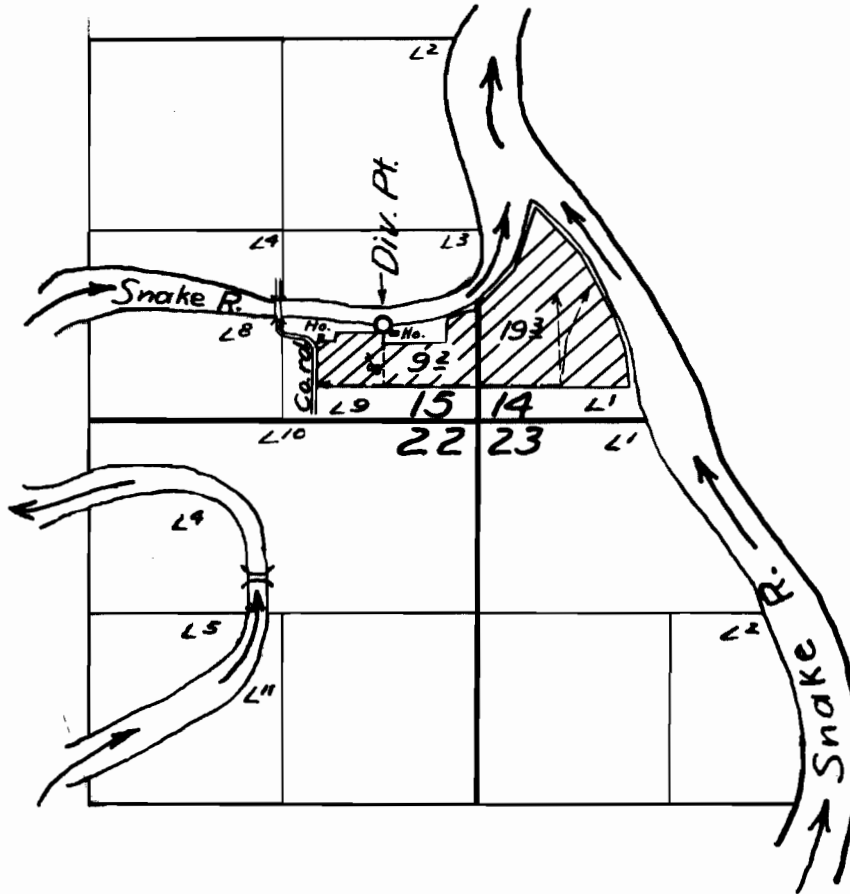

FINAL PROOF SURVEY

UNDER

Application No. 24638 Permit No. 19925

IN NAME OF

B.E. CARSON

Surveyed Oct. 4 1955, by M. Bish