


T. 6S. R. 2W. W.M.

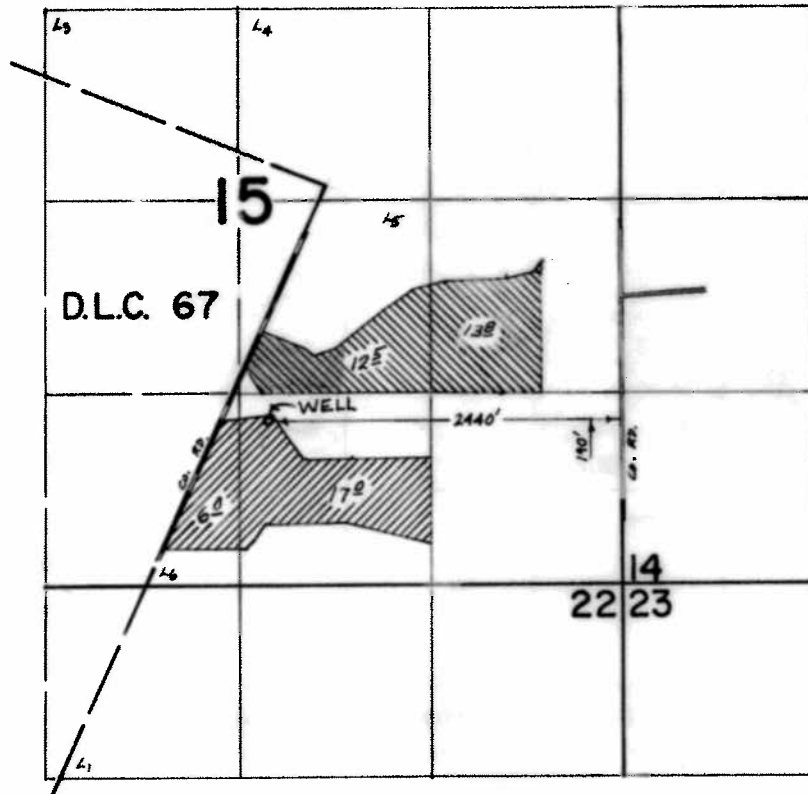

FINAL PROOF SURVEY UNDER

Application No. G-6087 Permit No. G-5169
IN NAME OF

LEO R. HAWLEY

Surveyed MAY 28 1975, by L. H. NUNN