


T. 7 S. R. 1 E. W. M.

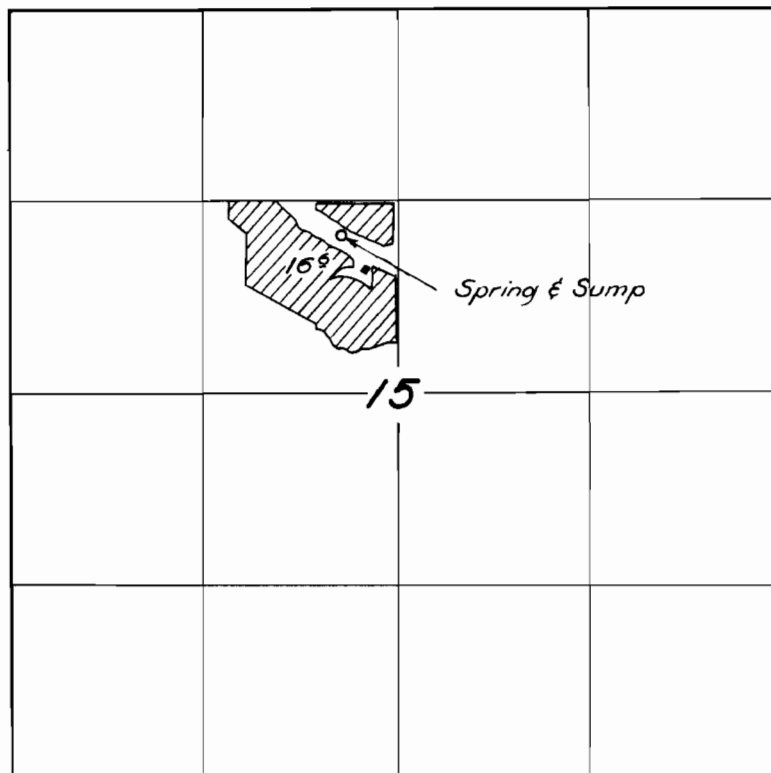

FINAL PROOF SURVEY

UNDER

Application No. 24804 Permit No. 19671

IN NAME OF

Mrs Nina Beckley

Surveyed 25 May 1956, by [Signature]