


T. 2S. R. 26E. W.M.

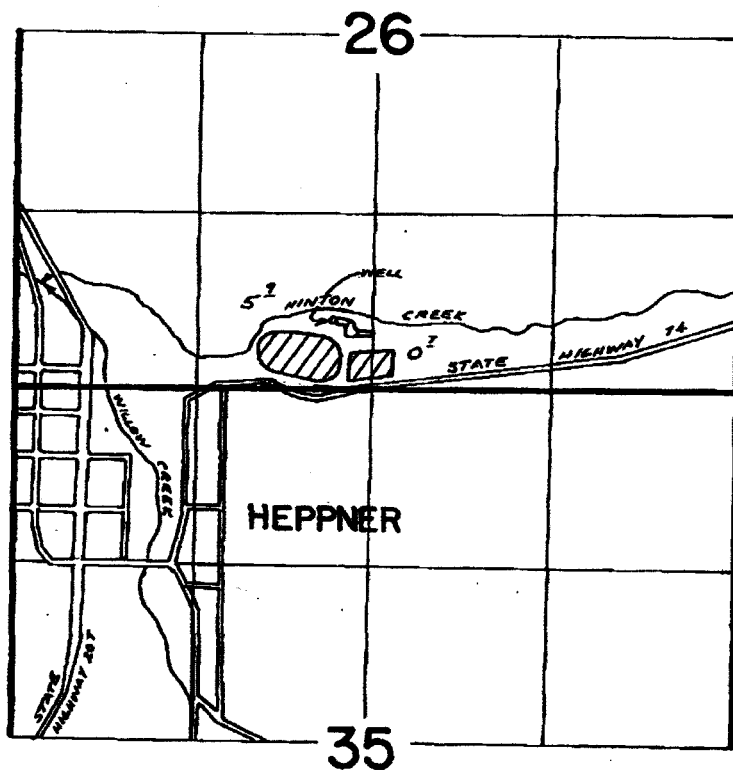

WELL LOCATED 600' N. & 300' W. FROM S. 1/4 COR SEC 26

FINAL PROOF SURVEY UNDER

Application No. G.5448 Permit No. G.5364
IN NAME OF

MORROW COUNTY FAIR BOARD

Surveyed DEC. 2 1977, by R. BARWIN