


G. 5802
45790

2
T. 8 S., R. 26 E.W.M.
N½ of Sec. 6

RECEIVED

AUG 29 1973
STATE ENGINEER
SALEM, OREGON

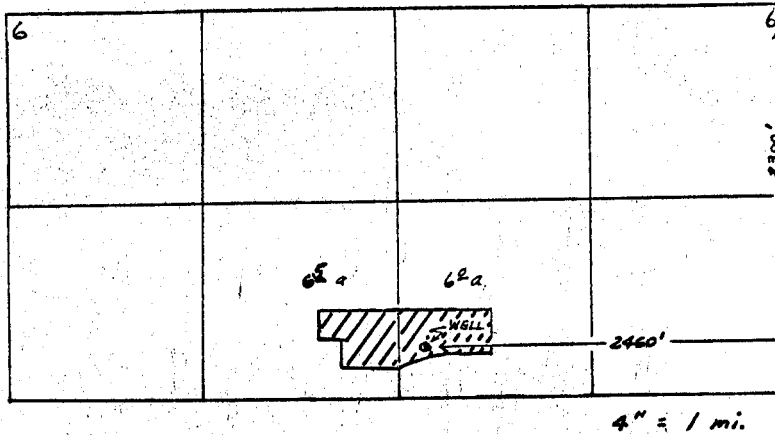

A Map to accompany application for groundwater
in the name of Archie Munkers of Heppner, OR. 97836

Application No. G 6132
Permit No. G 5802