


T.1S. R.3E. W.M.

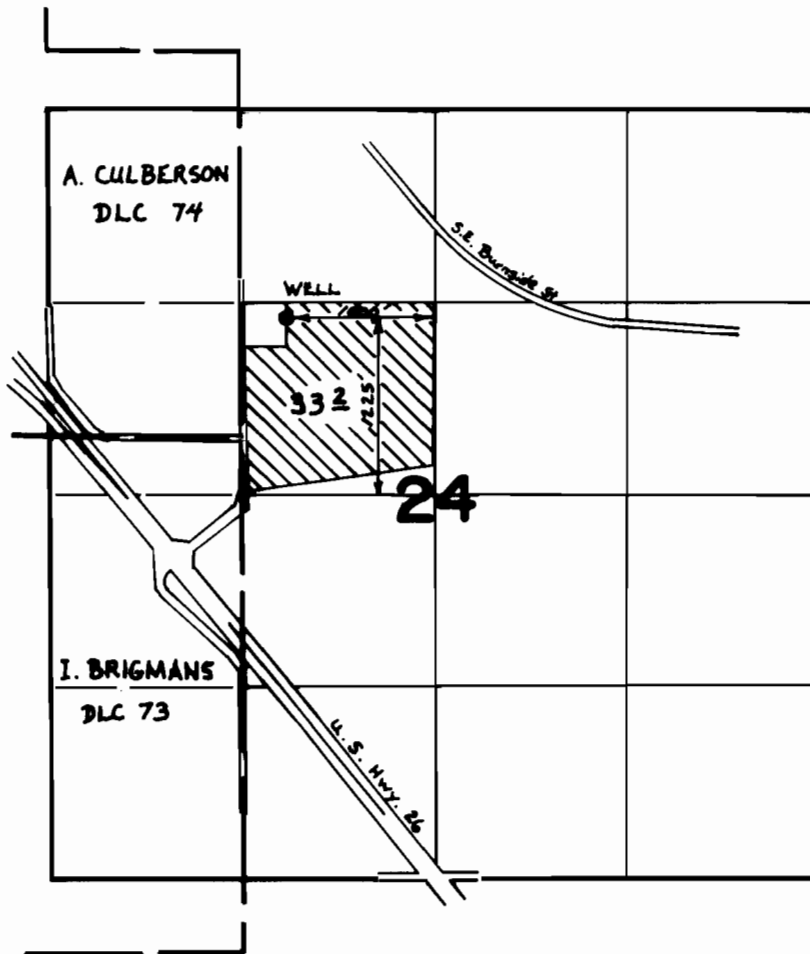

FINAL PROOF SURVEY
UNDER

Application No. **G-5561** Permit No. **G-5432**
IN NAME OF

LESTER M. JOHNSON

Surveyed **AUG. 11, 1976**, by **L.E. GOULD**