T.1 S. R.3 E. W.M.

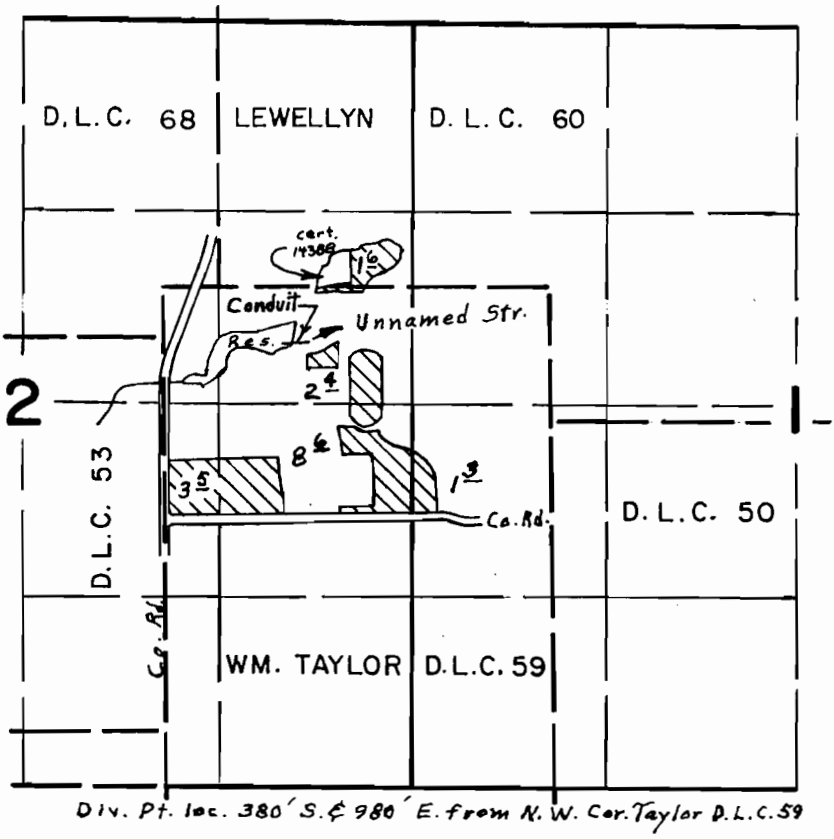

FINAL PROOF SURVEY
UNDER

R.-44214 R-5085
Application No. 44215 Permit No. 32935
IN NAME OF
EAST SIDE AREA EDUCATION DISTRICT
(MT. HOOD COMMUNITY COLLEGE)

Surveyed Aug. 9, 1976, by L. E. Gould

DEQ-144-B