


# T.I.S. R.3E. W.M.

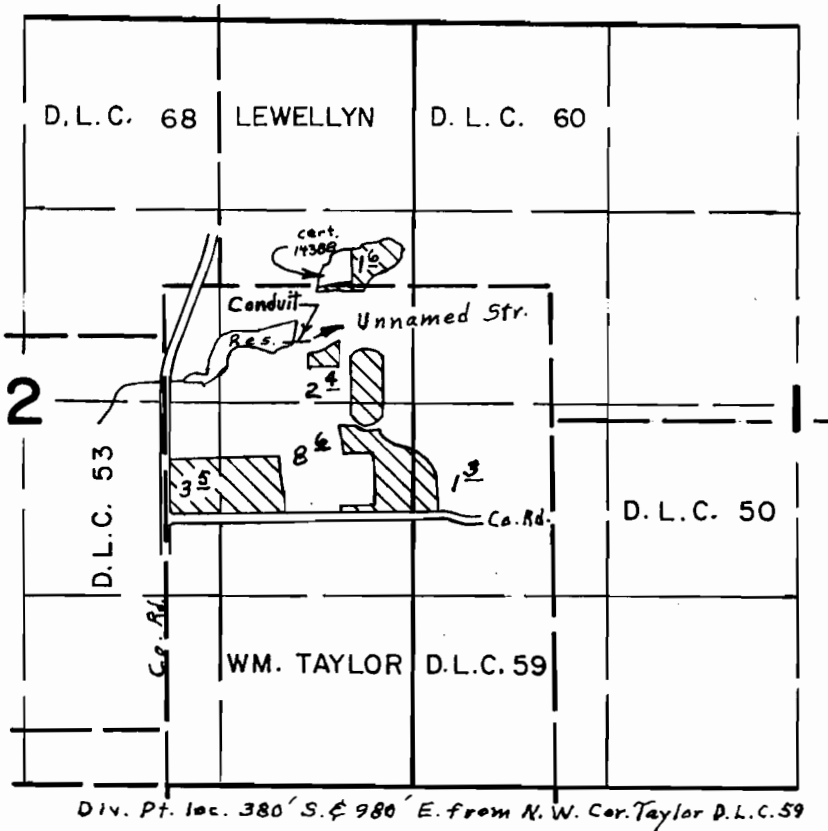

## FINAL PROOF SURVEY UNDER

R-44214

R-5085

Application No. 44215 Permit No. 32935

IN NAME OF

EAST SIDE AREA EDUCATION DISTRICT  
(MT. HOOD COMMUNITY COLLEGE)

Surveyed Aug. 9, 1976, by L. E. Gould.