


T.6S.,R.4W.,W.M.

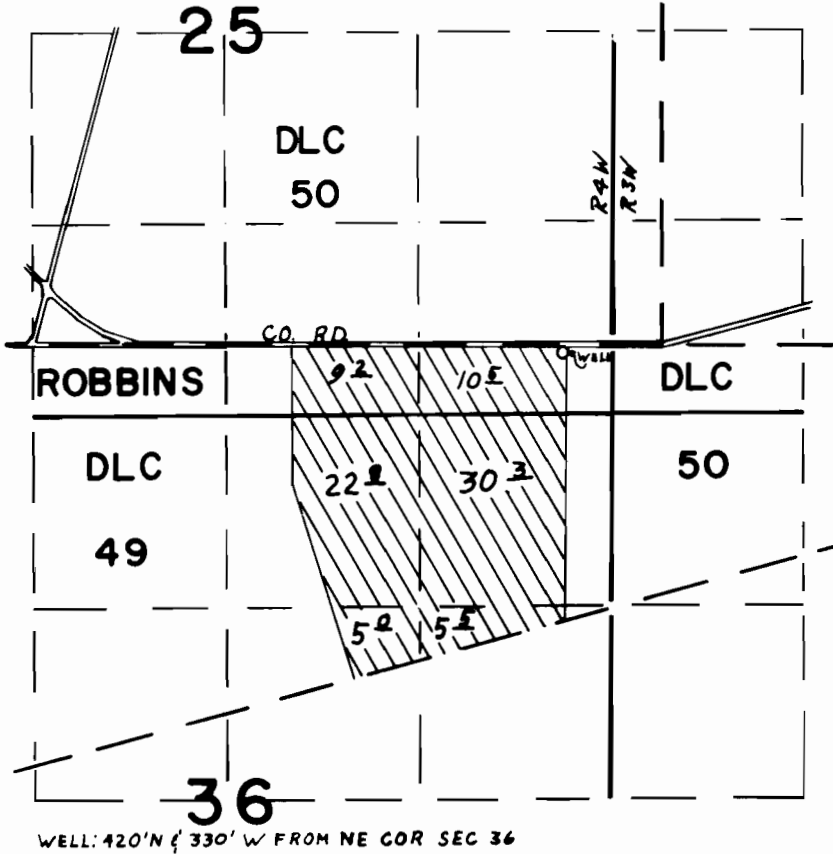

FINAL PROOF SURVEY
UNDER

Application No. G-5958. Permit No. G-5655.
IN NAME OF

GORDON WALKER

Surveyed MAY 21, 1976, by G.R. KING