


T. 7 S. R. 6 W. W. M.

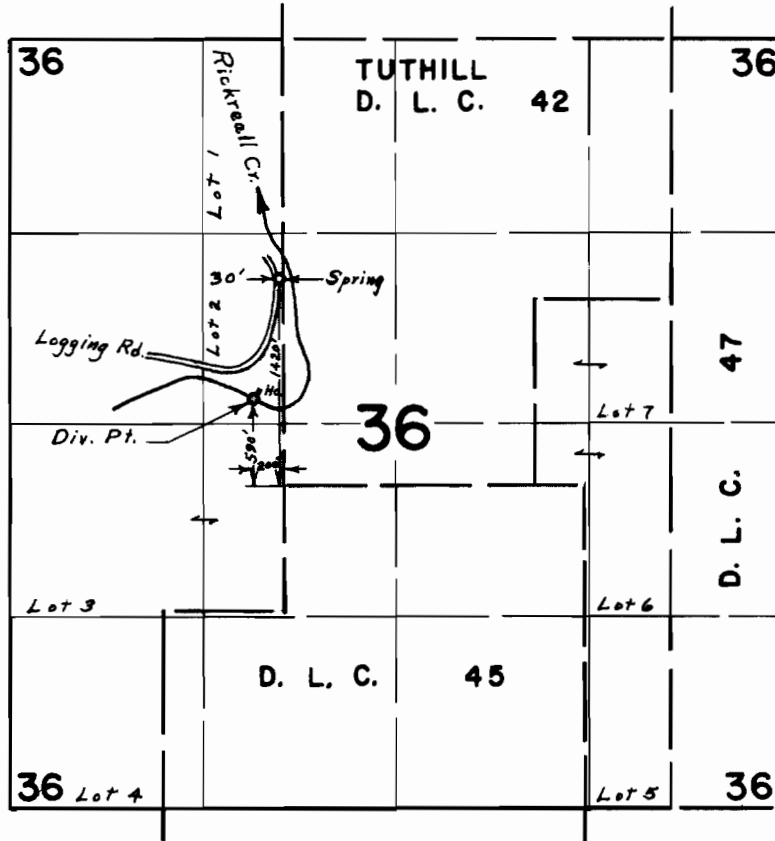

**FINAL PROOF SURVEY**  
UNDER

Application No. 38945. Permit No. 28976.  
IN NAME OF

*Leander & Frances Marie Quiring*

Surveyed July 24, 1969, by Donald Buell