


T.8S.R.6W.W.M.

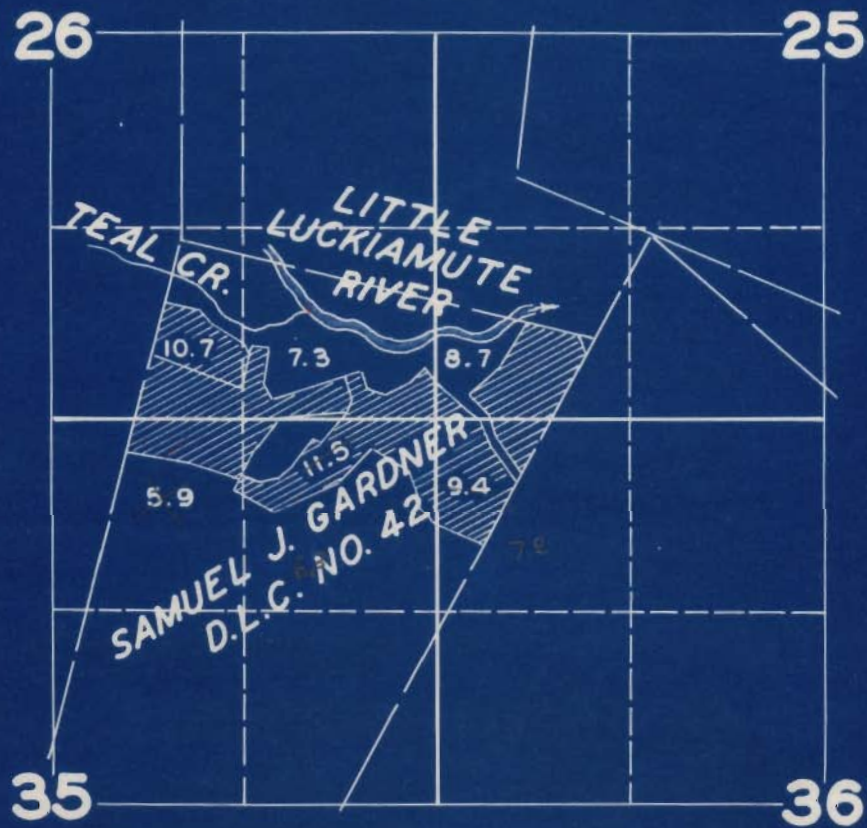

FINAL PROOF SURVEY

UNDER

Application No. 17909 Permit No. 13595

IN NAME OF

WILEY M. GARDNER

Surveyed APR. 26 1949, by JAS. E. BUNNELL