


T.8S.R.6W. W.M.

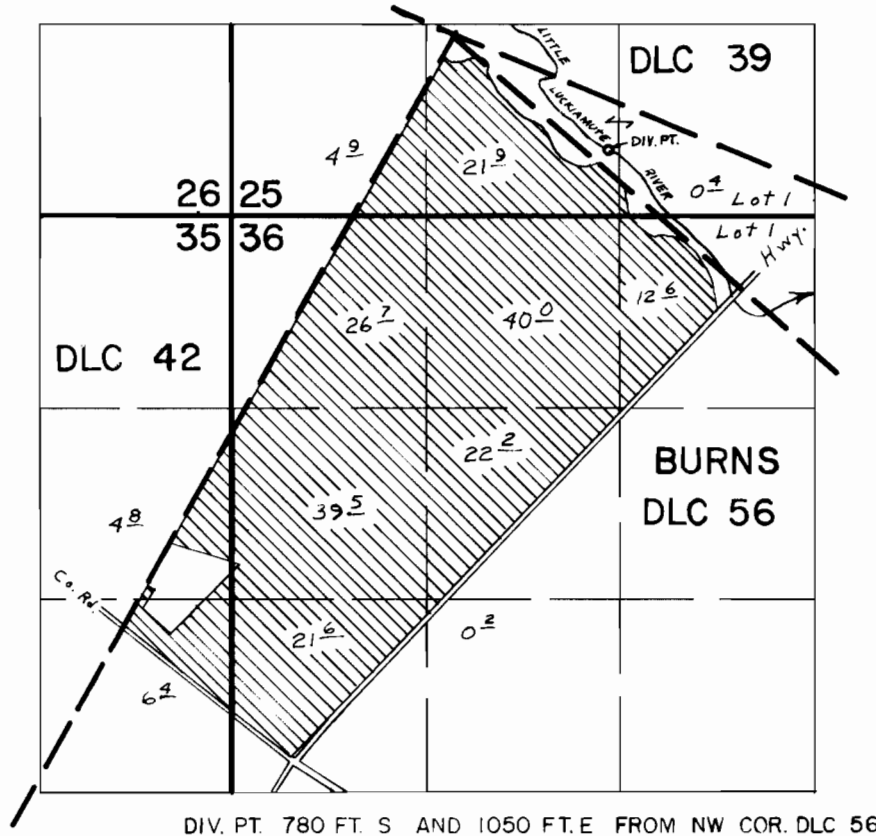

FINAL PROOF SURVEY UNDER

Application No. 41994 Permit No. 31428
IN NAME OF

KENNETH GARDNER


Surveyed NOV 21 19.72 by L. GOULD

T#3574

TO

T-3575

FROM

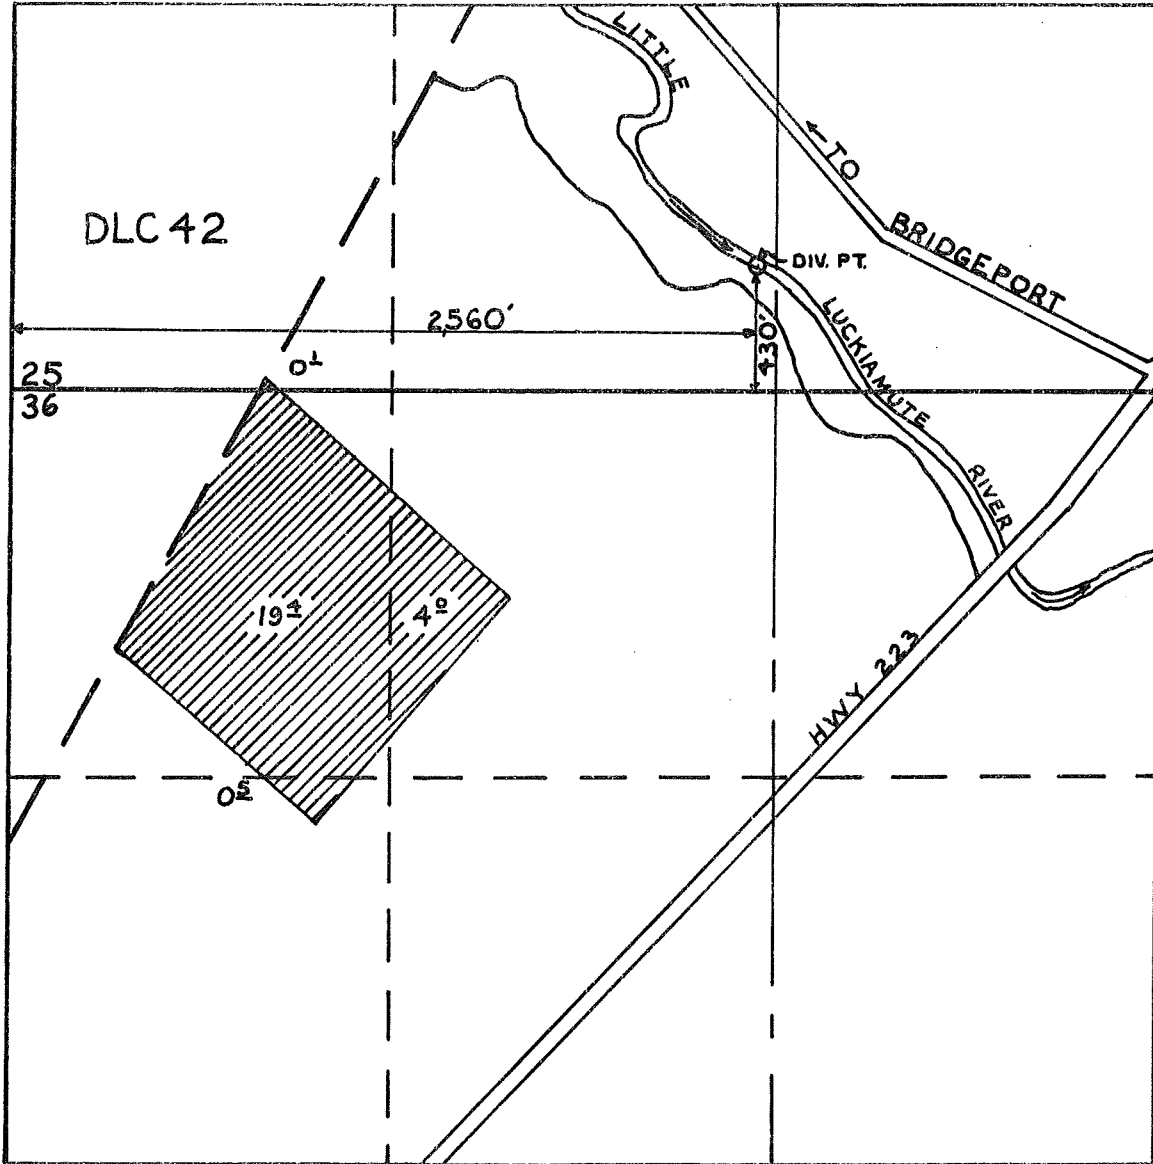


KENNETH GARDNER

T.8S. R.6W. W.M.

AREA TO BE IRRIGATED **//////**

T# 3576
FROM

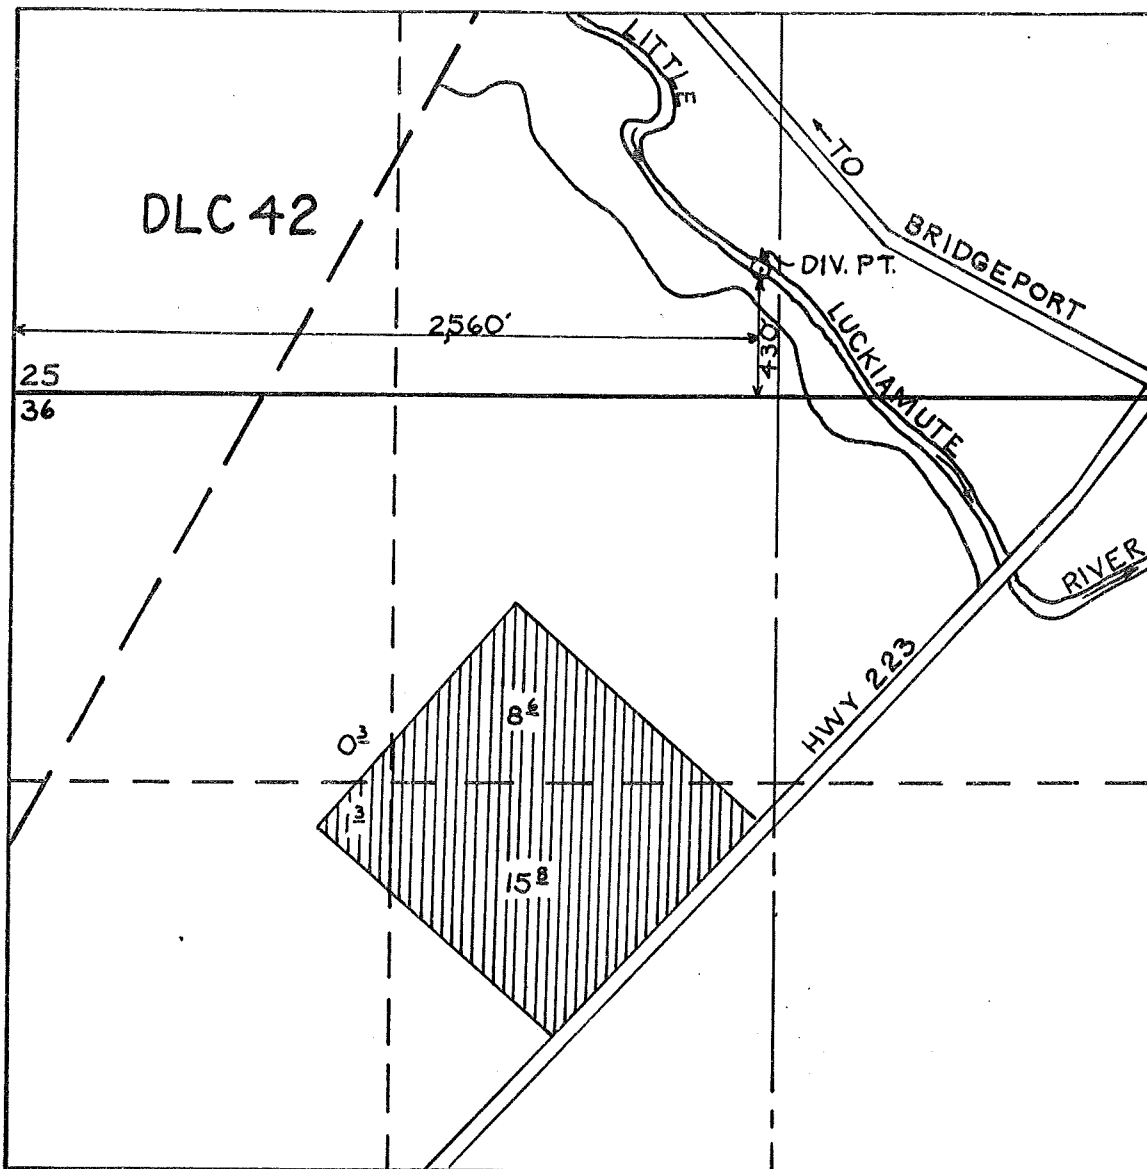

KENNETH GARDNER

T8S R6W W.M.

AREA TO BE IRRIGATED IIIII