


T.5S. R.10W. W.M.

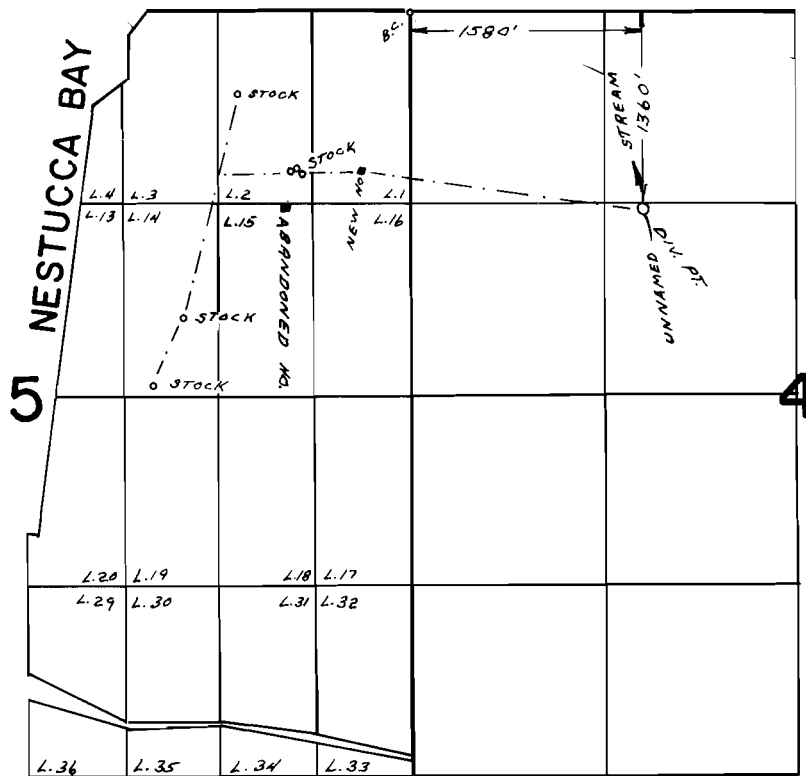

FINAL PROOF SURVEY

UNDER

Application No. 40543 Permit No. 30217
IN NAME OF

ESTATE OF ALBERT STAEHLY.....

Surveyed AUG. 4 1977, by L.H. NUNN