


G-4340

45912

T.3N.,R.33E.,W.M.

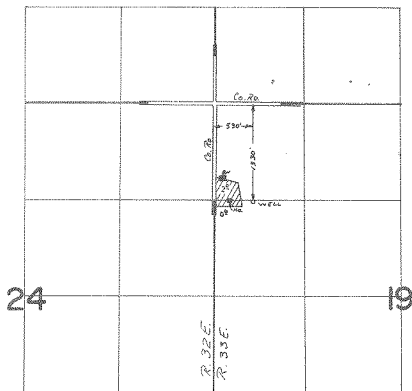

FINAL PROOF SURVEY UNDER

Application No. G-4617. Permit No. G-4340.
IN NAME OF

EDWARD ROEHLK

Surveyed APRIL 9, 1975, by L. Tall