


T.2N.,R.31E.,W.M.

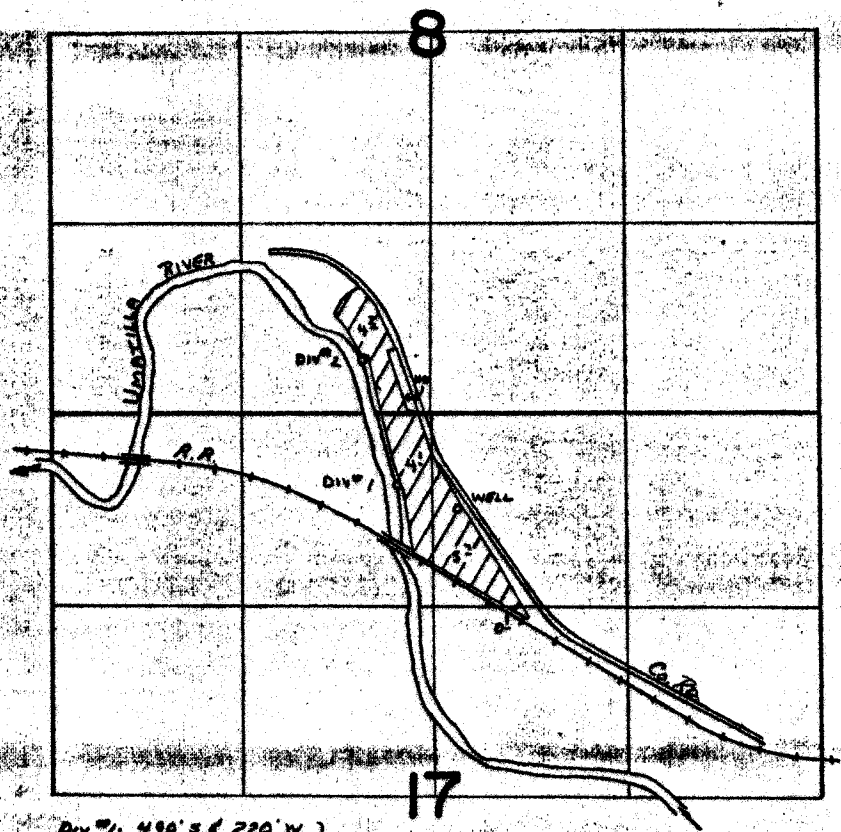

Div #1 - 490' S & 220' W }
 Div #2 - 380' N & 470' W } FROM 5/4 COR SEC 8
 Well - 660' S & 180' E }

FINAL PROOF SURVEY UNDER

Application No. **45513** Permit No. **33966**
G-4676 **G-4404**
 IN NAME OF

MARVIN G. DALLMAN

Surveyed April 3, 1975 by L. To. II