


G-5611

43812
STATE ENGINEER
SALEM, OREGON

T. 2 N., R. 32 E. W. M.

Scale = 1" = 400'

Application No. G-5888
Permit No. G-5611

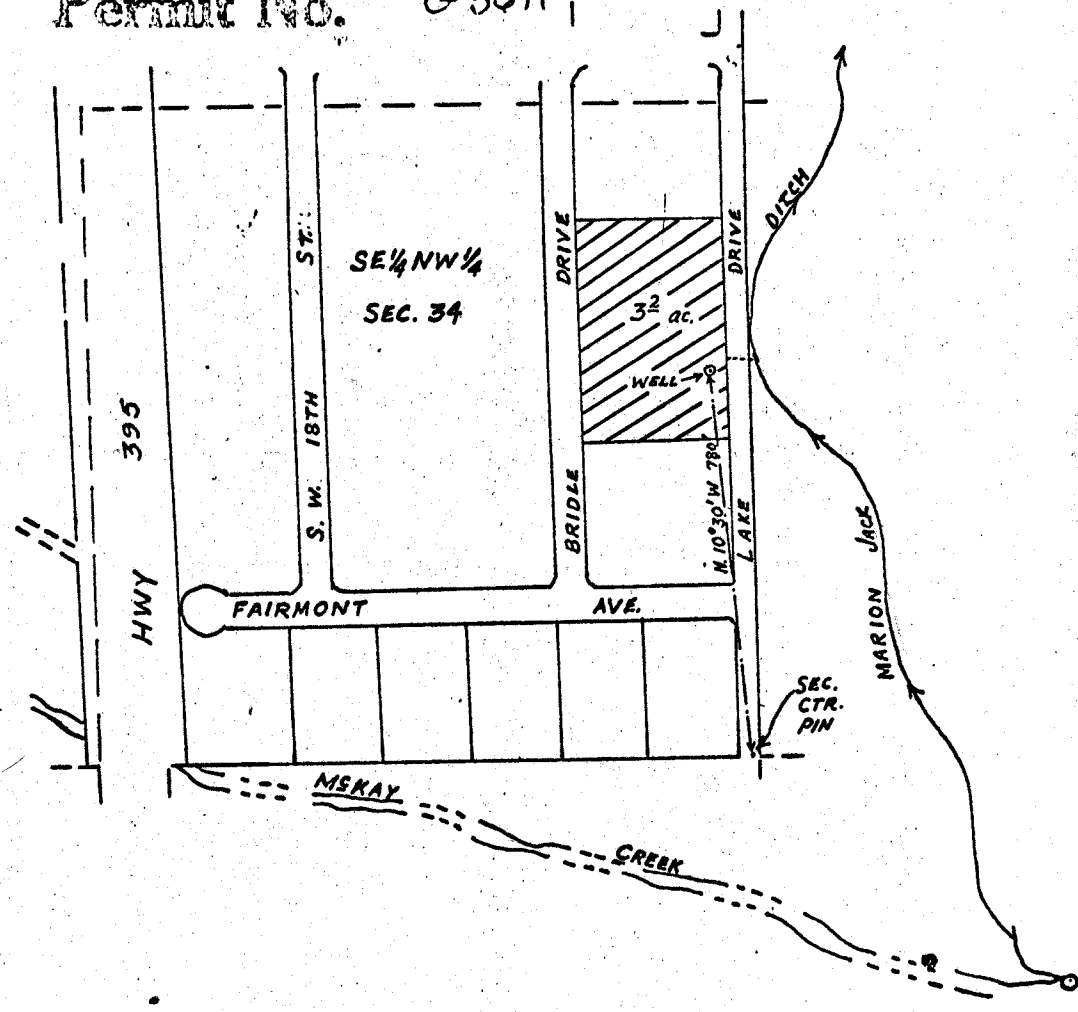

Map to accompany groundwater application
in the name of William F. Hubel.