


T. 2N. R. 31E. W.M.

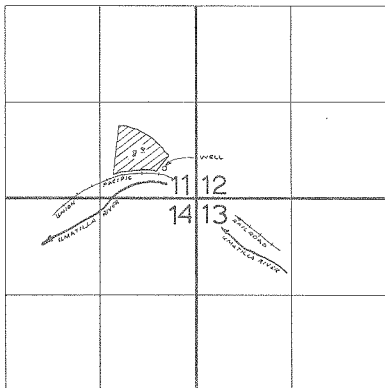

WELL LOCATED 400' N. & 436' W. FROM SE COR SEC 11

FINAL PROOF SURVEY
UNDER

Application No. G.5929... Permit No. G.5636...

IN NAME OF

.....LEONARD E. HERBES.....

Surveyed ..OCT..19. 1977., by ..R..BARWIN.....