


G-5734
48818

T.6N.,R.35E.,W.M.

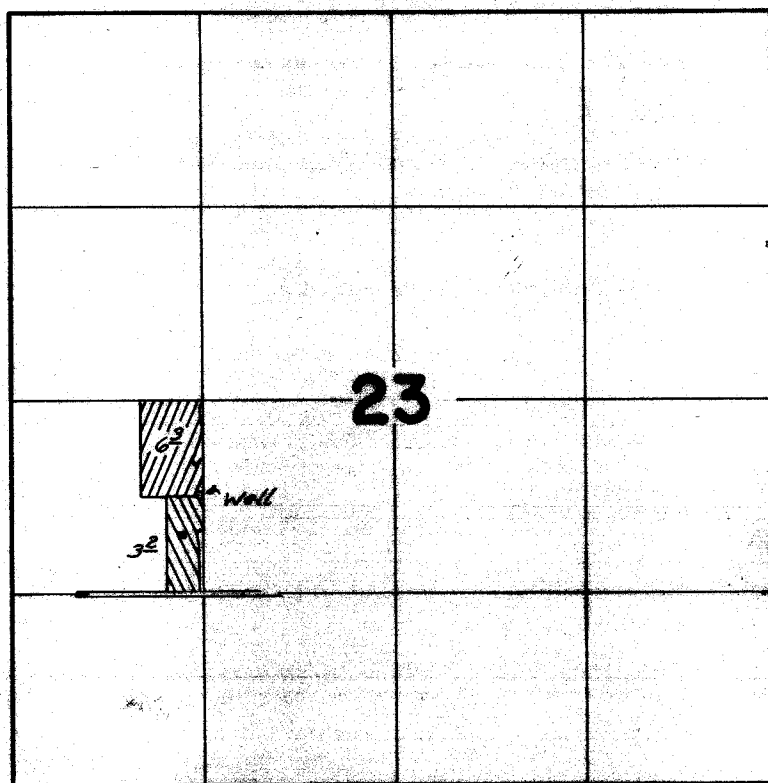

Well Loc.: 640' S. & 1300' E. from W 1/4 Cor. Sec. 23

 Primary
 Suppl.

FINAL PROOF SURVEY
UNDER

Application No. G-6039 Permit No. G-5734
IN NAME OF

James W. Hoerler

Surveyed Apr. 8, 1976 by C.R. King

NZ-5MM-29 LB