


G-5263  
45820

# T.6N.,R.35&36E.W.M.

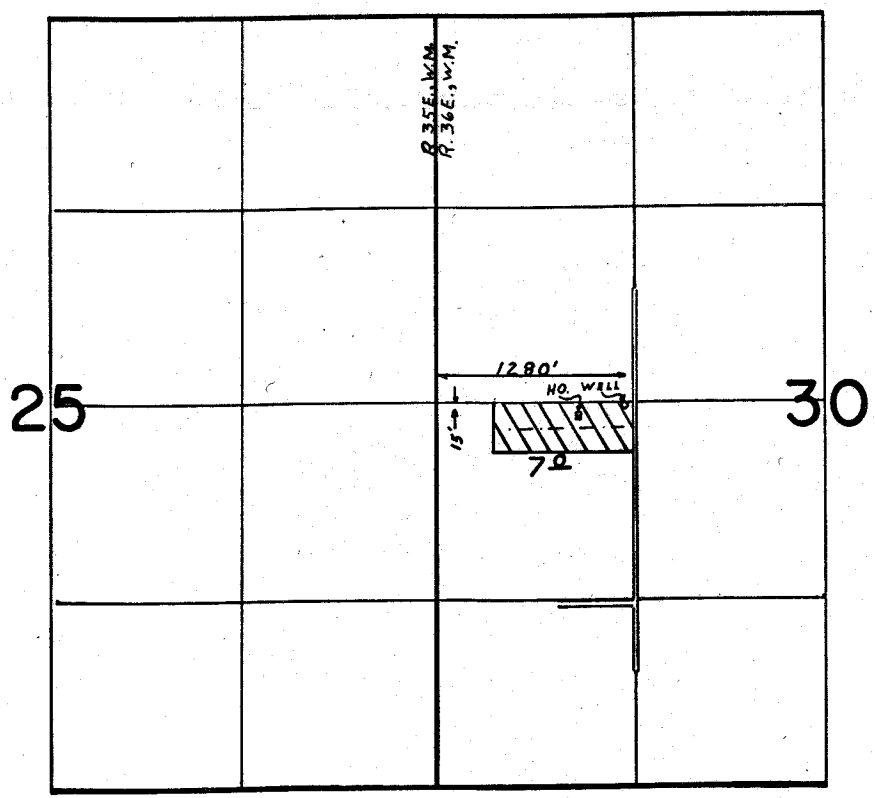

## FINAL PROOF SURVEY UNDER

Application No. G-6392 Permit No. G-5263  
IN NAME OF

LEBURN ADDINGTON

Surveyed APRIL 13 1976., by G.R. KING