


T.4N.R.35E.W.M.

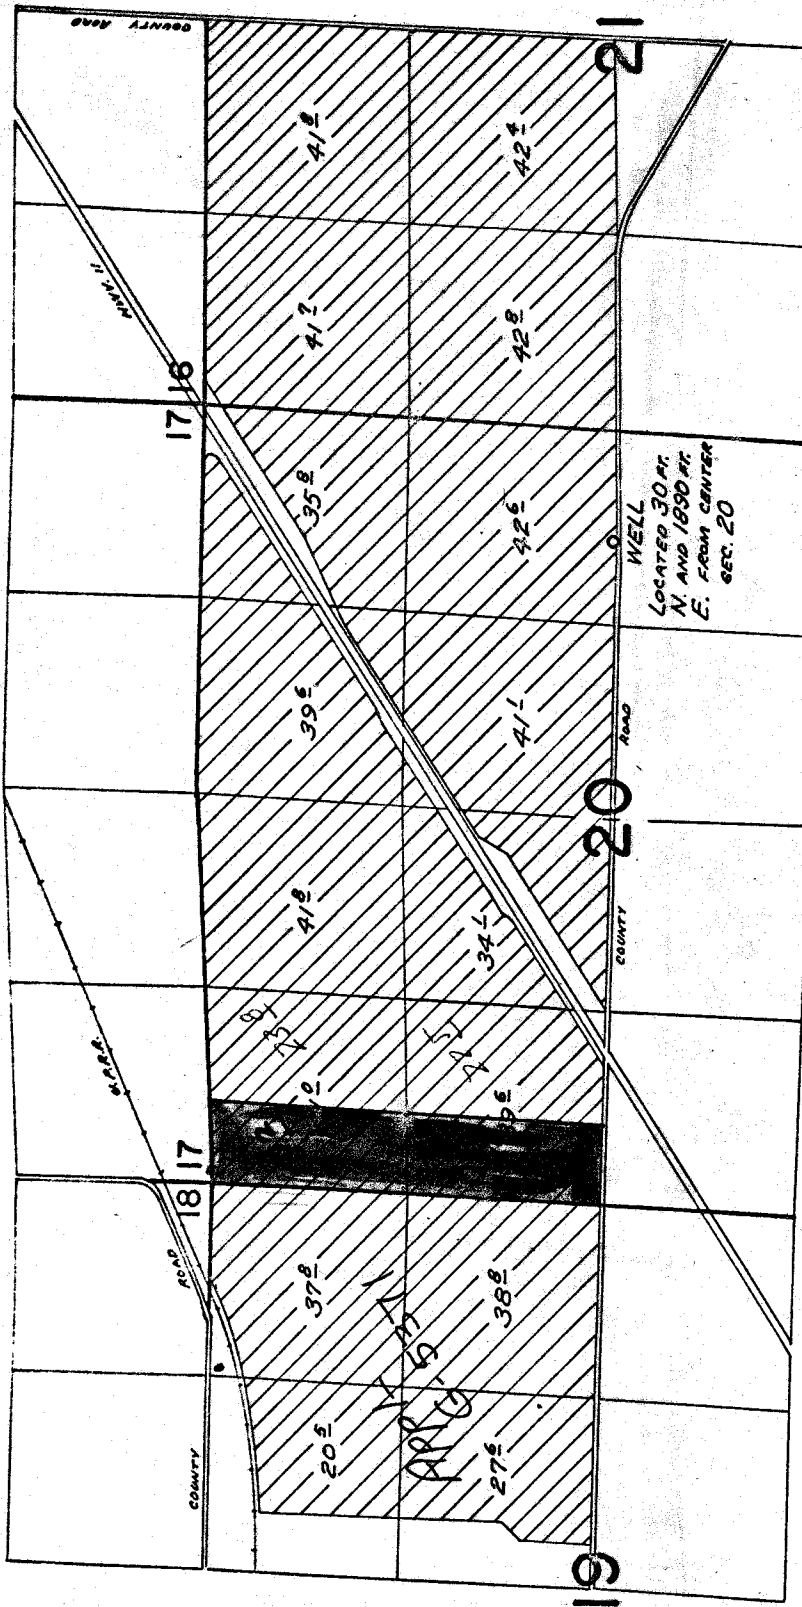

Application No. G 6662
Permit No. G 6220

RECEIVED

45823

SEP 17 1974

STATE ENGINEER
SALEM, OREGON

G-6220

FINAL PROOF SURVEY
UNDER

R. G. Mucken

Application No. G-4730, Permit No. G-4450
IN NAME OF

HAROLD & LOLA BARNETT, INC.

Surveyed Apr. 17, 1973, by R. G. Mucken

STATE ENGINEER