


T.2N. R.32E. W.M.

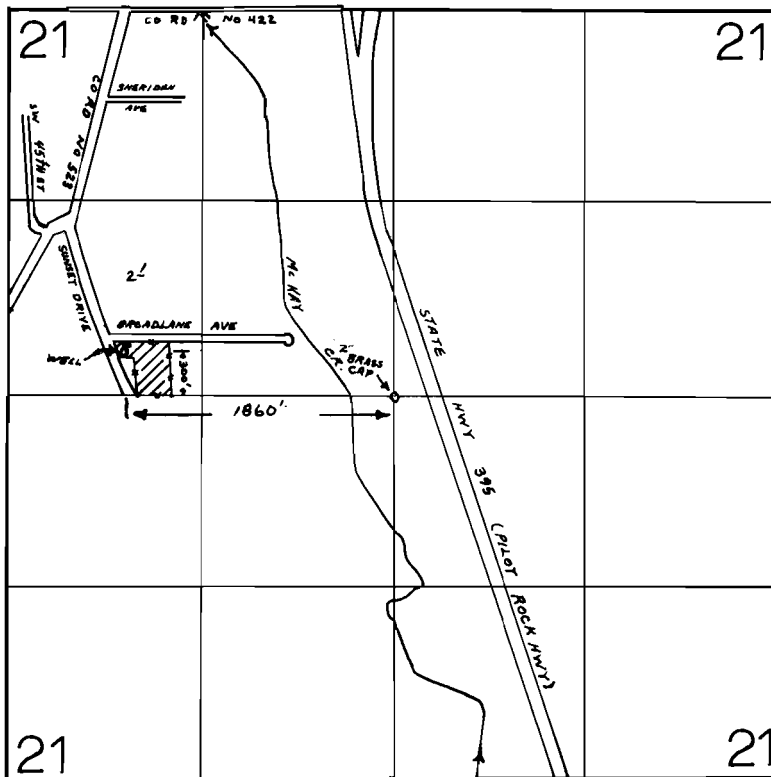

**FINAL PROOF SURVEY**  
UNDER

Application No. G-6668 Permit No. G-6224  
IN NAME OF

.....CECIL. N. DOUGHERTY.....

Surveyed SEPT. 30 1977, by R. BARWIN..