


RECEIVED G-6340

JUL 16 1975

45825

WATER RESOURCES DEPT.
SALEM, OREGON

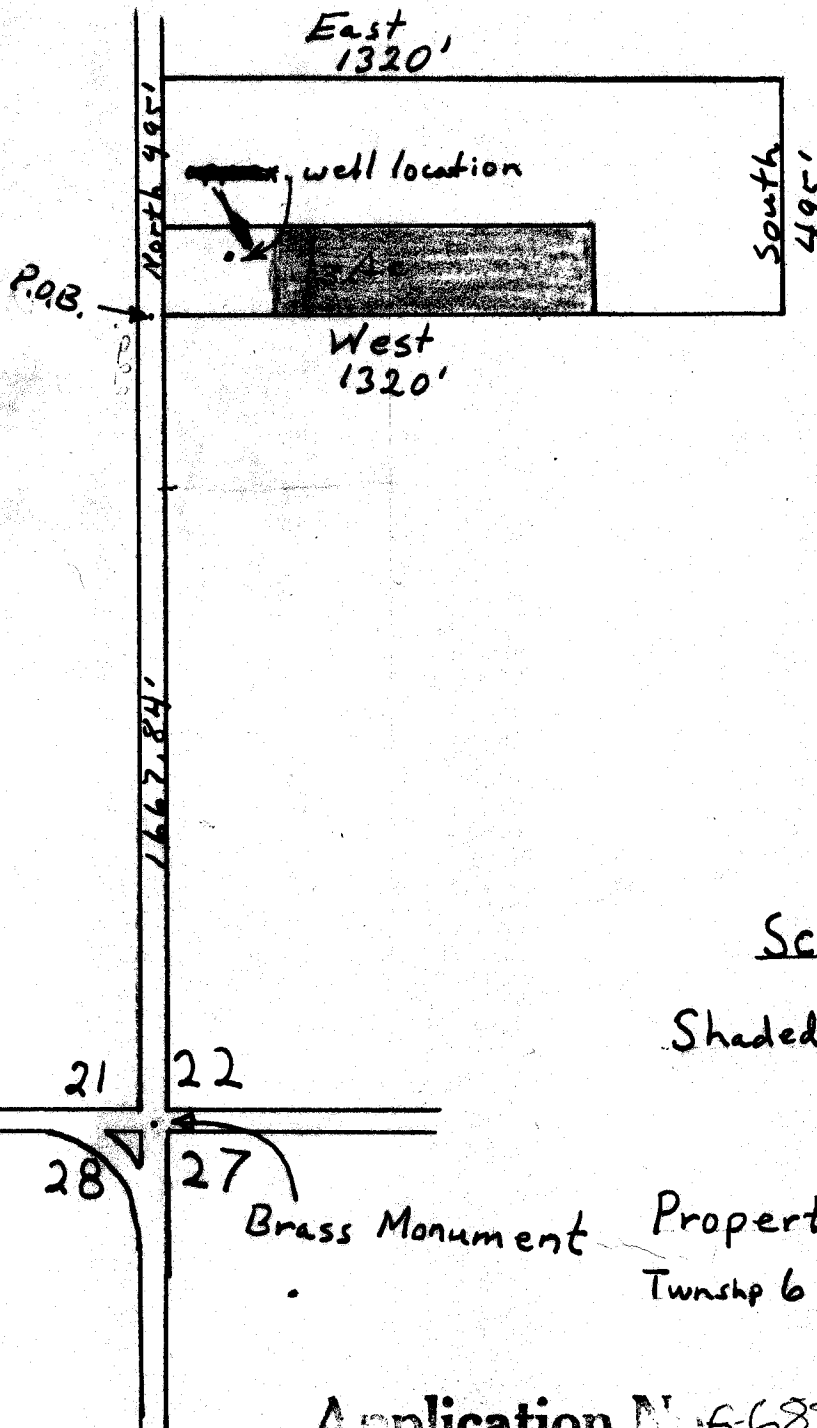

Scale 1"=400'

Shaded area to be watered

Property is in section 22
Township 6 N. Range 35 E. W.M.

Application No. 66882
Permit No. G 6340