


T.6N.,R.35E.,W.M.

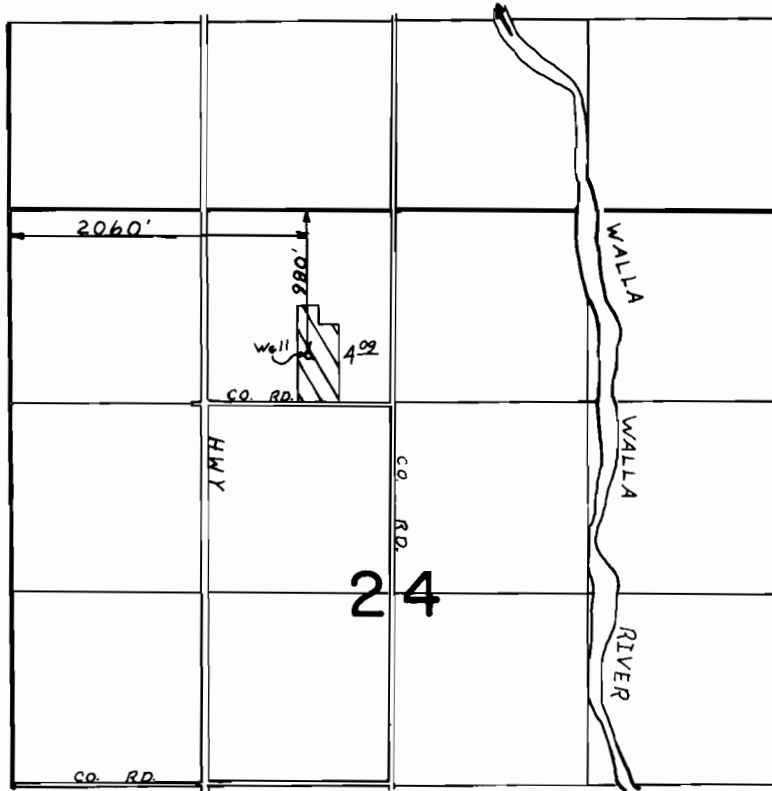

**FINAL PROOF SURVEY**  
UNDER

Application No. G- 7066 Permit No. G- 5817  
IN NAME OF

**GORDON H. & HELEN IRENE EVANS**

Surveyed APRIL 8, 1976., by C.R. KING.....