


T.2S.,R.32E.,W.M.

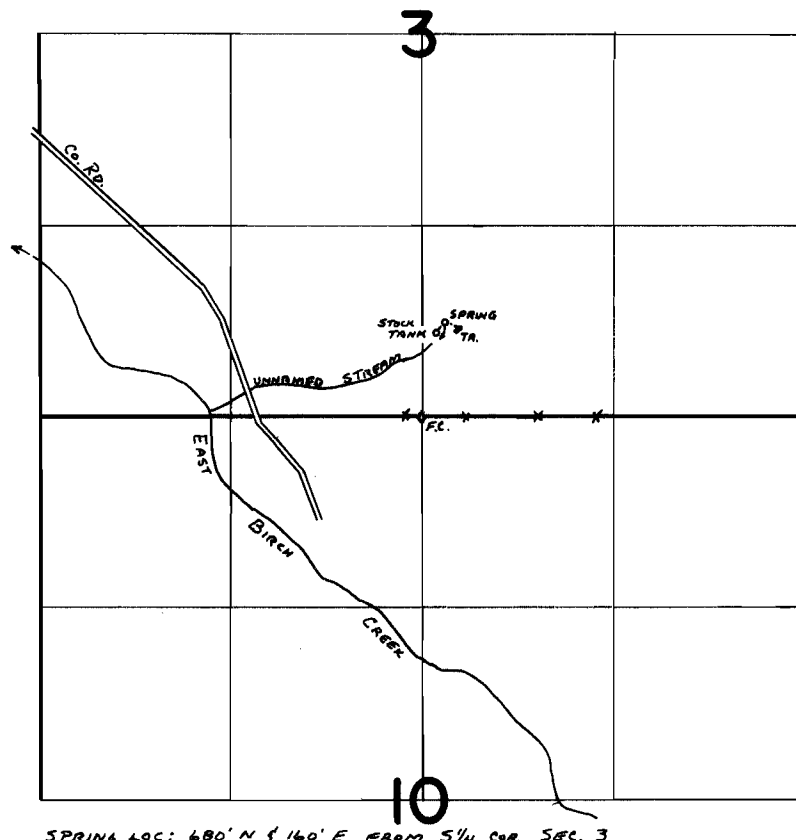

FINAL PROOF SURVEY
UNDER

Application No. 38987 Permit No. 29046
IN NAME OF

ORVILLE HUMPHREYS

Surveyed APRIL 2 1975, by L. Tall