
T.3N.,R.35E.,W.M.

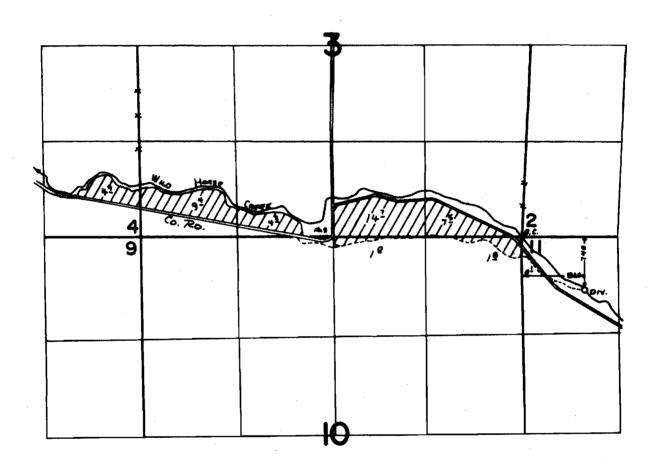

FINAL PROOF SURVEY

Application No. .49892.. Permit No. .29399... IN NAME OF

EMERY C. GENTRY & SON