


T.3N.,R.35&36E.,W.M.

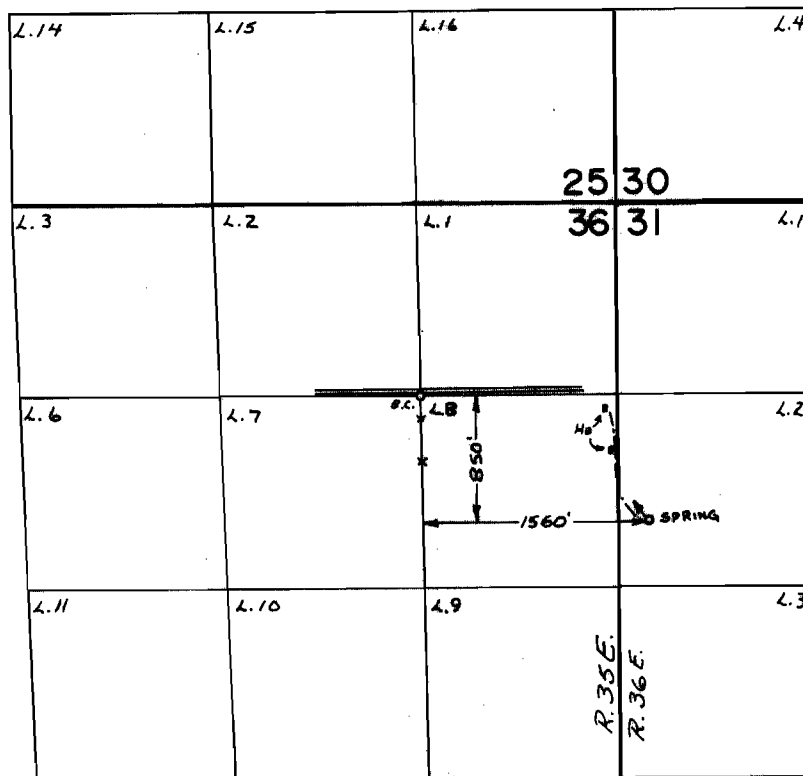

FINAL PROOF SURVEY UNDER

Application No. 43829 Permit No. 32804
IN NAME OF

ROBERT M. HOSKINS

Surveyed APRIL 5 1975, by L. Tall