


T.3N.,R.33E.,W.M.

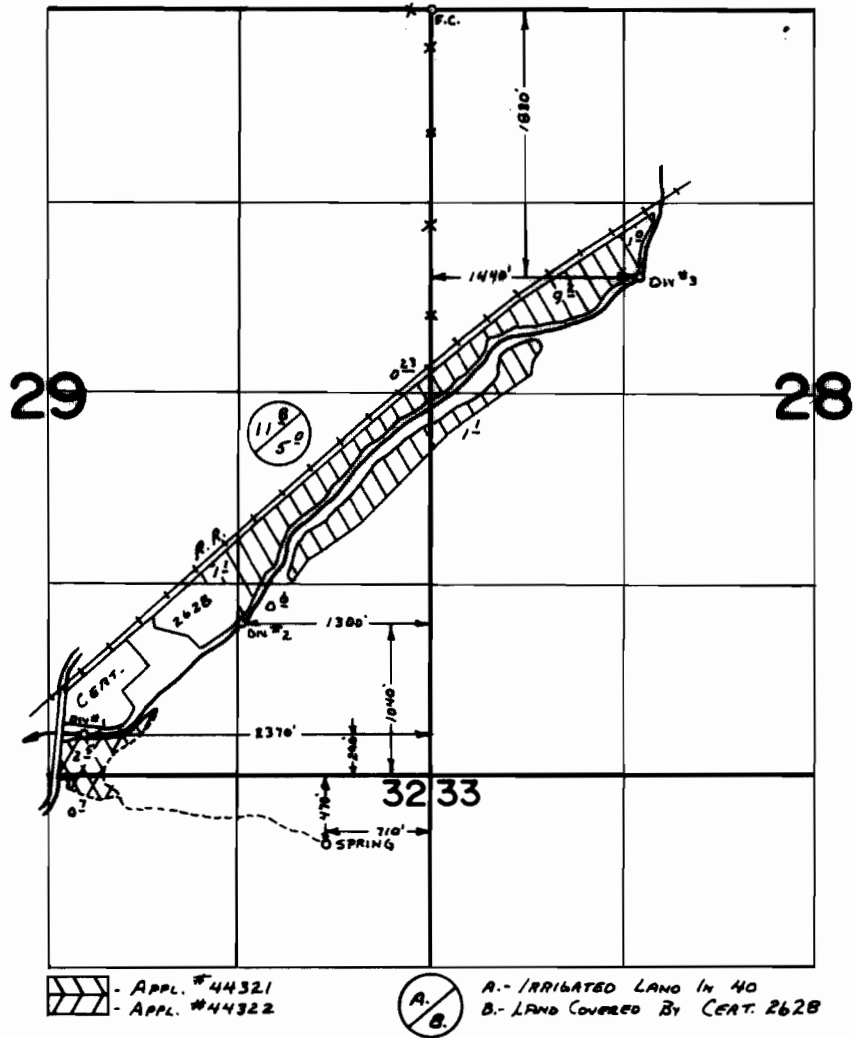

FINAL PROOF SURVEY UNDER

Application No. **44321** Permit No. **33097**
 Application No. **44322** Permit No. **33098**

IN NAME OF

RALPH A. TACHELLA, JR.

Surveyed **APRIL 10, 1975**, by **L. Tall**