


T.3N.,R.33E.,W.M.

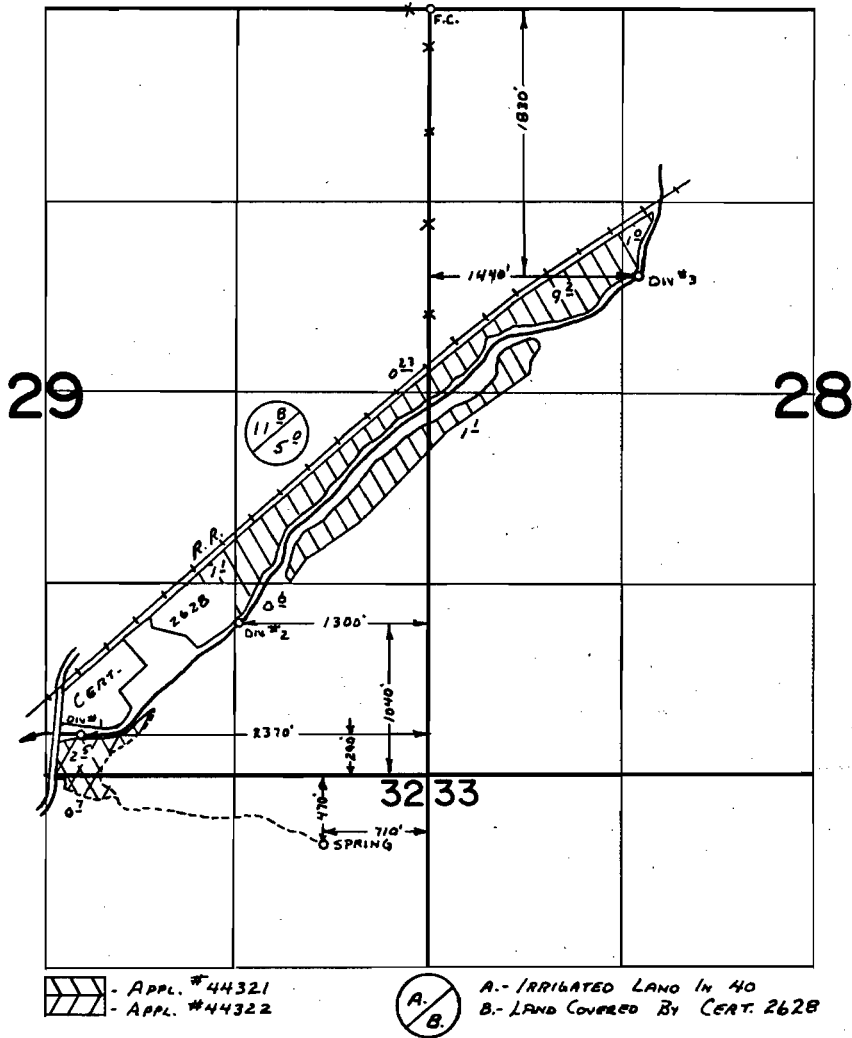

FINAL PROOF SURVEY UNDER

Application No. **44321** Permit No. **33097**
44322 Permit No. **33098**
 IN NAME OF

RALPH A. TACHELLA, JR.

Surveyed **APRIL 10, 1975**, by **L. Tall**