


T. 2S. R. 38E. W.M.

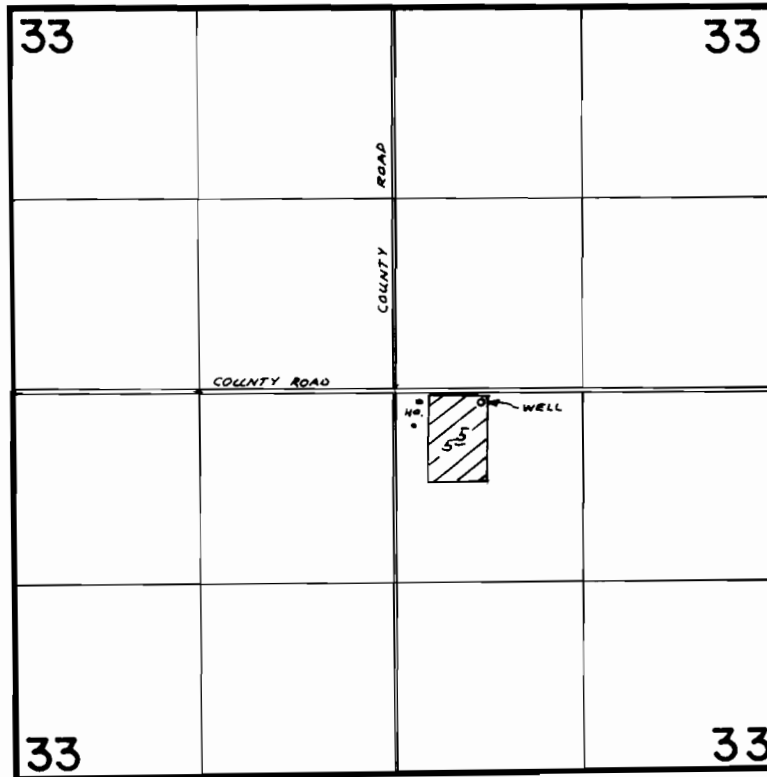

WELL LOCATED 80'S. & 590'E. FROM NW COR NW 1/4 SE 1/4 SEC 33

**FINAL PROOF SURVEY**  
UNDER

Application No. .G.6791.... Permit No. .G.6301....  
IN NAME OF

HAROLD T. MORMAN

Surveyed OCT. 11, 1977, by R. BARWIN