


T.2S., R.3W., W.M.

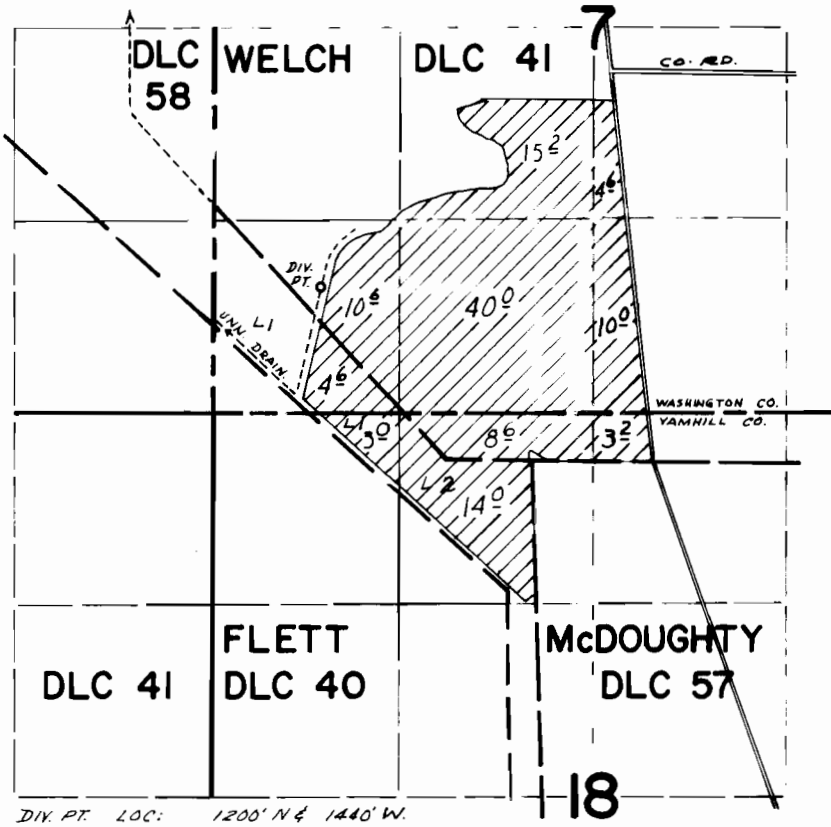

**FINAL PROOF SURVEY**  
UNDER

Application No. **46158** Permit No. **34484**  
IN NAME OF

**JOHN KOPPLIN**

Surveyed **Oct. 8** 1975, by **D. Norby**