


# T. 1 N. R. 3 W. W.M.

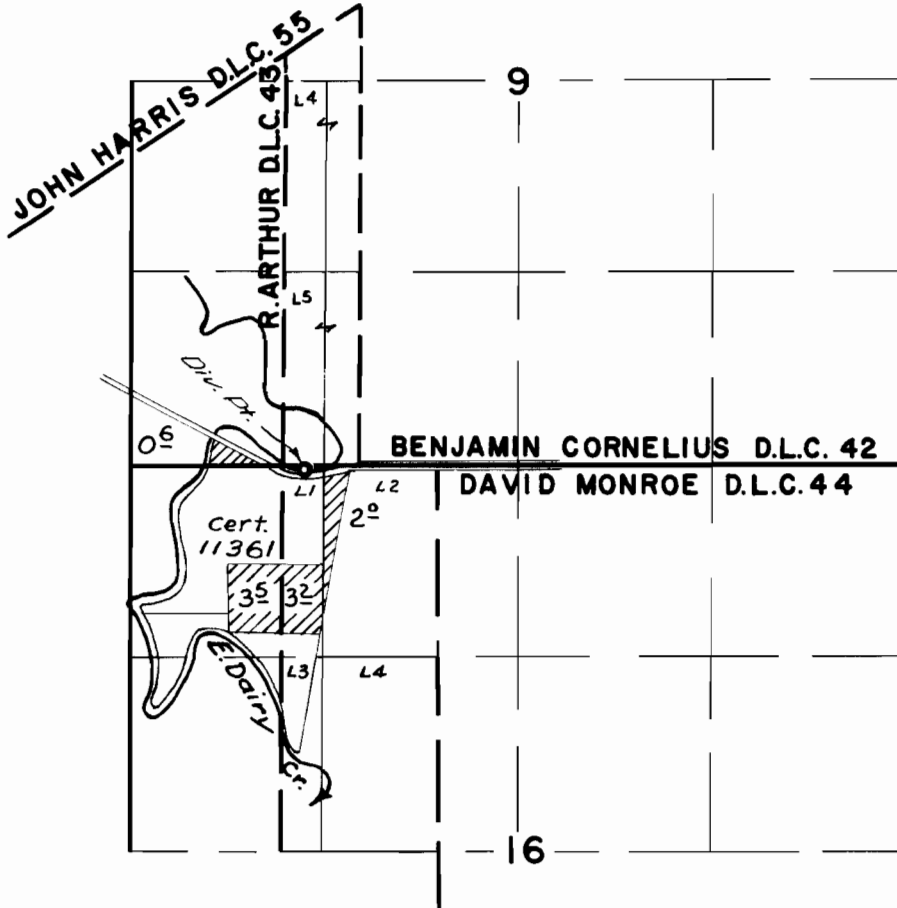

## FINAL PROOF SURVEY UNDER

Application No. 26786 Permit No. 21044  
IN NAME OF

*ELMER W. SAHNOW*

Surveyed April 16, 1956, by *R.H. Whitby*