


T.3S. R.2W. W.M.

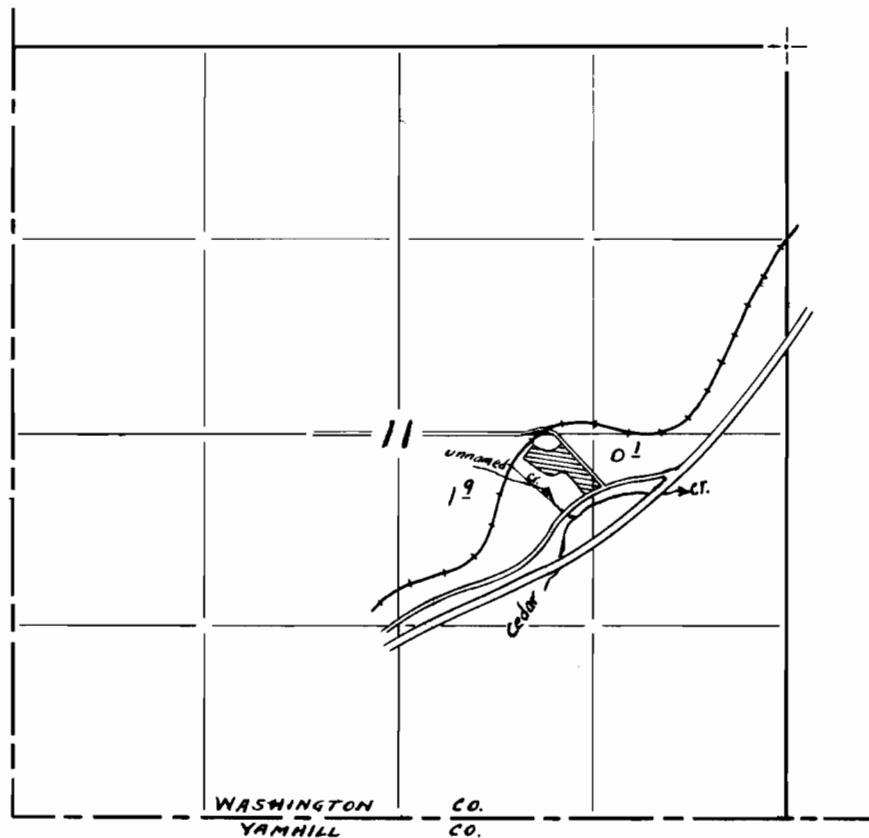

FINAL PROOF SURVEY

UNDER

Application No. 28652 Permit No. 22567
IN NAME OF

LLOYD C. BARON

Surveyed 5-3 1956 by R.H. WHITBY