


T.3S.R.2W.W.M.

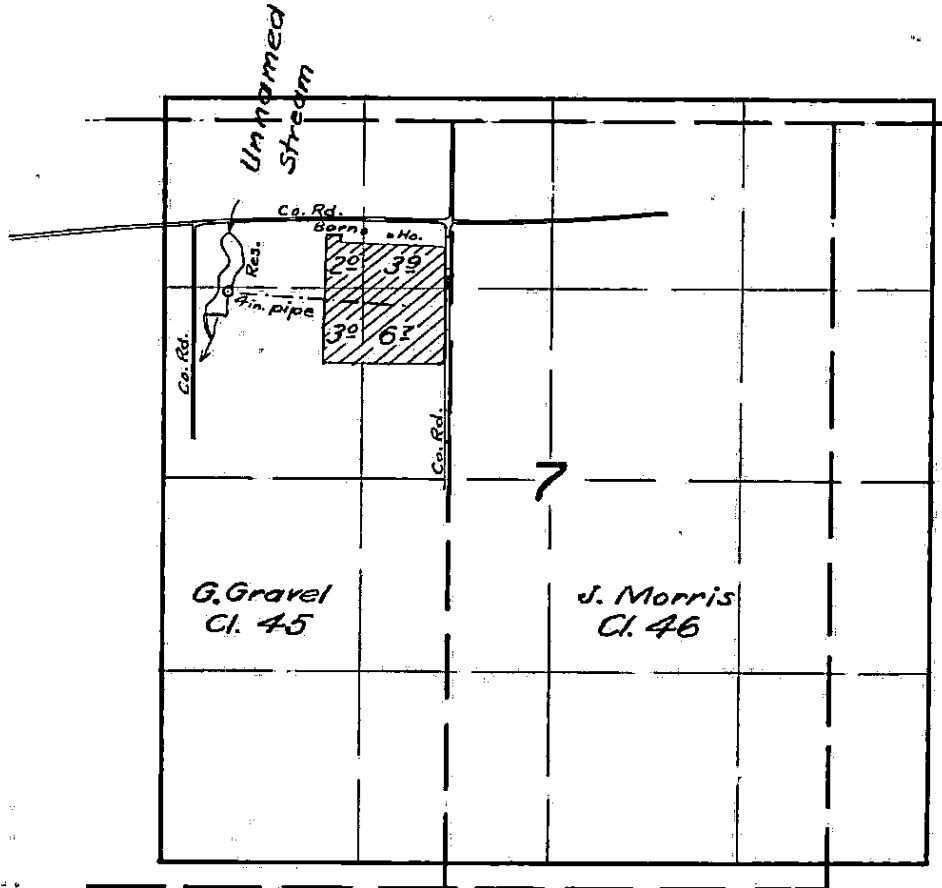

FINAL PROOF SURVEY

UNDER

26055

21244

Application No. ~~R-27328~~ Permit No. ~~R-1375~~

IN NAME OF

Fred F. Brunner

Surveyed Mar. 31 1956 by M. B. B.