


T.8S.,R.45 & 46E.,W.M.

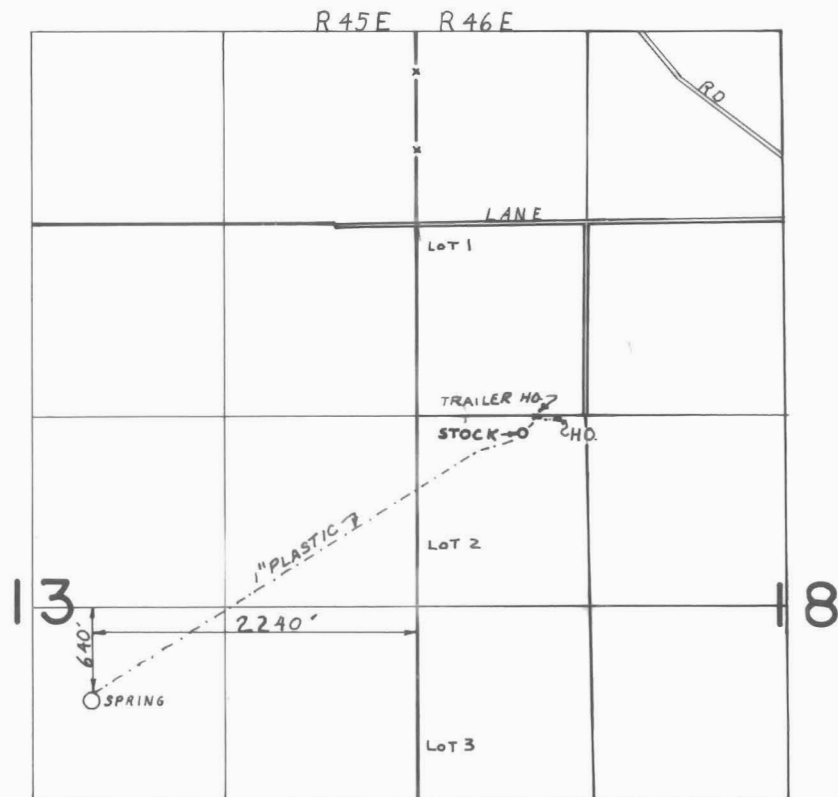

FINAL PROOF SURVEY
UNDER

Application No. 49562 Permit No. 37095
IN NAME OF _____

ERSEL LEE CLARK & MARGERY A. SKILES

Surveyed JUNE 16, 1976, by C.R. KING