


T.11S., R 5W., W.M.

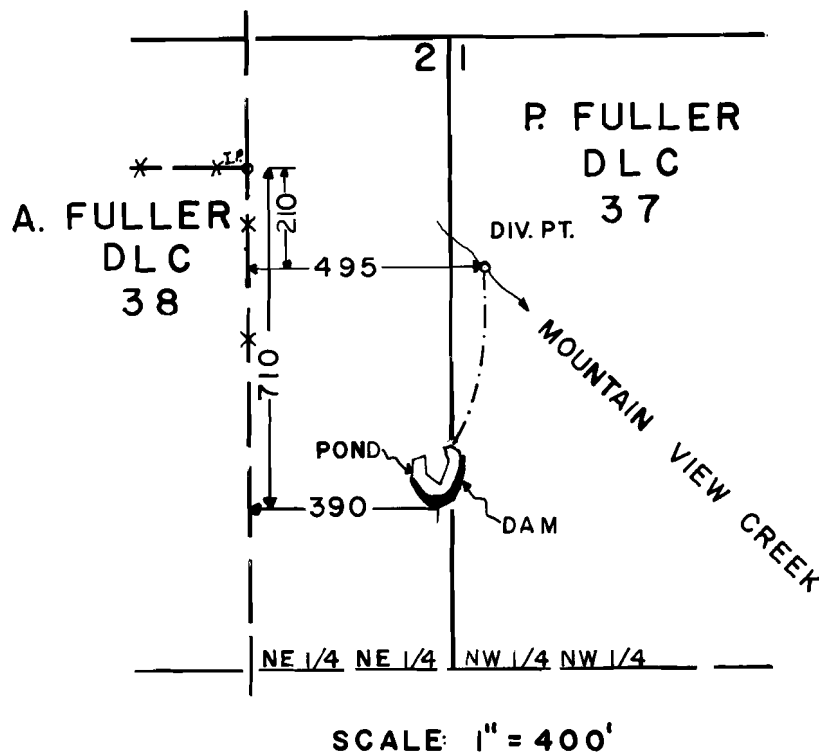

FINAL PROOF SURVEY
UNDER

R-48530 R- 5853
Application No.48531 Permit No.36145...
IN NAME OF

VINCENT W. SCHUETZE

Surveyed OCT. 4, 1976, by C.R. KING