


T.12S.,R.6W.,W.M.

NW1/4 SW1/4 SEC 31

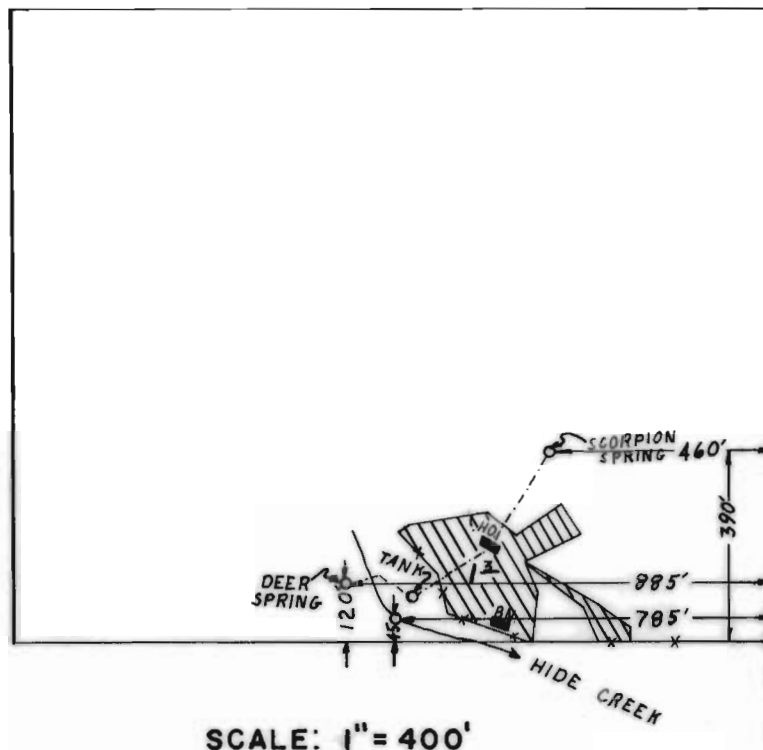

FINAL PROOF SURVEY
UNDER

Application No. 49415 Permit No. 37028
IN NAME OF

JOHN E. KELLEY

Surveyed JULY 6 1976, by C.R. KING