


T.14S. R.5W.W.M.

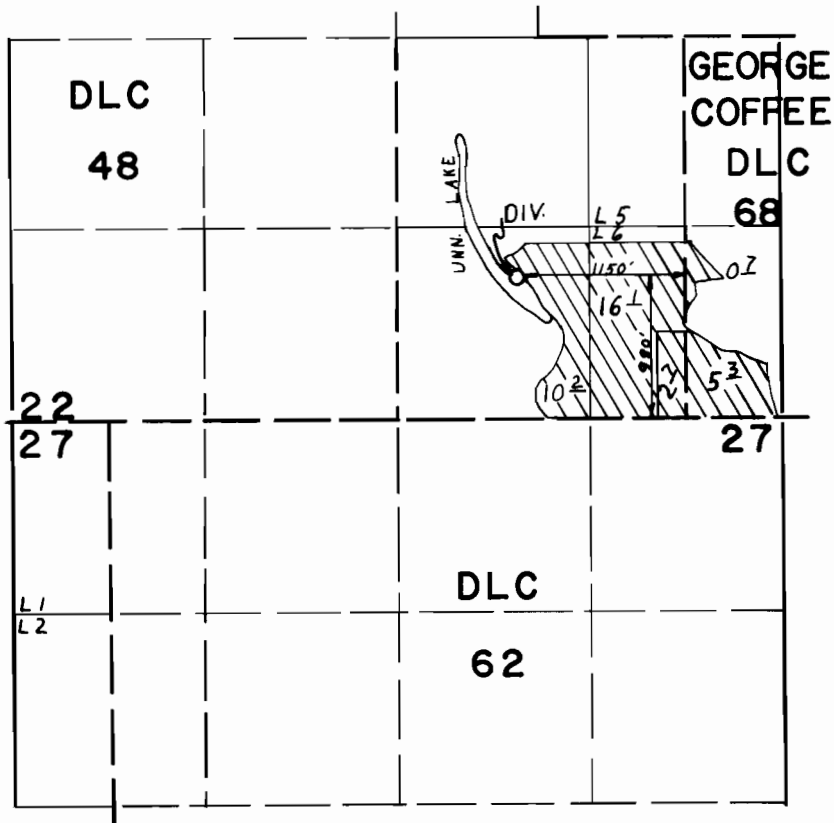

**FINAL PROOF SURVEY**  
UNDER

Application No. 49656 Permit No. 36250  
IN NAME OF

MELVIN BECKER

Surveyed APR. 2. 1976, by C.R. KING